IREDELL COUNTY HEALTH DEPARTMENT

Paid 125.00 11:30

STATESVILLE 704-878-5305 MOORESVILLE 704-664-5281

IMPROVEMENT PERMIT / AUTHORIZATION TO CONSTRUCT / OPERATION PERMIT / EXISTING SYSTEM INSPECTION

PERMIT# 89099 PIN# ~~4669 00 3656 PT~~ 4669 00 3656 PT 4668-09-9379 DATE 7/24/00

OWNER OR CONTRACTOR MIKE KROM PHONE: Business 664-3671 Home

ADDRESS 149 YACHT COVE LN

LOCATION 115 N- TR SHINNVILLE RD- TL BROOKGLEN- ON RT CORNER

SUBDIVISION BROOK GLEN BLOCK / SECTION 1 LOT 4 LOT AREA .54AC SITE CLASS. PS DESIGN FLOW 360GPD L.T.A.R. .25 3rd/4th

Septic Tank: 1000 Gallons; STB 1007 Date 28-00
Pump Tank: Gallons; PT Date
Pump Make: Model Serial No.
Nitrification Field: No Fields 1 Square Feet 1080 Linear Feet 360
No Lines 4@90' Trench Width 36" Max Trench Bottom Depth 36" Gravel Depth n/a

☑ New System ☐ Repair System Type: I, II, (III), IV, V, VI
System Description: GRAVITY INNOVATIVE
Repair System Description: GRAV. PANEL
Maintenance Agreement Required: ☐ Yes ☑ No

☑ House/Mod. Home No. Bedrooms 3
☐ Mobile Home No. Bathrooms 2
☐ Business No. Employees
☐ Other
☐ Slab ☑ Crawl Space ☐ Basement w/plumbing ☐ Basement wo/plumbing


Water Supply: ☑ Individual ☐ Public ☐ Community

Comments:/Conditions:

Comments:/Conditions:

★ Well not installed at time of inspection.

INITIAL SITE SKETCH 1"=50'

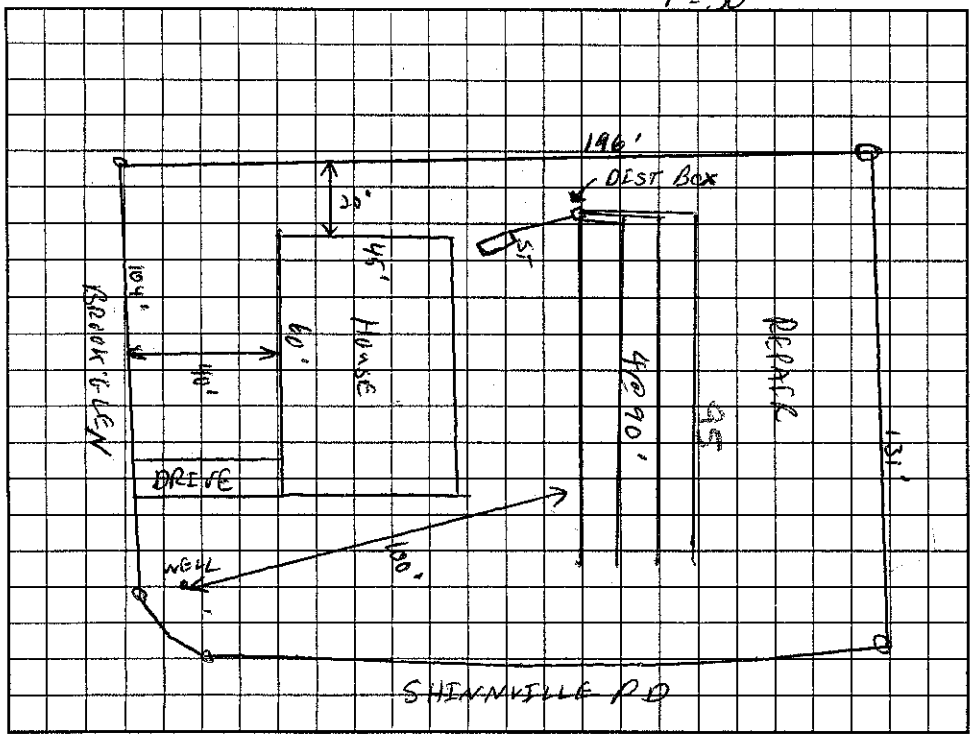

AS BUILT SKETCH

Installed as Drawn (Plastic Chamber Used)

Permit can be suspended or revoked if any false information is supplied toward securing the permit/any unauthorized changes are made to the site/any unauthorized changes are made in the installation of the system. Improvement Permit with plat valid without expiration. Improvement Permit with site plan valid for sixty months. Authorization to Construct is valid for a period equal to that of Improvement Permit – not to exceed sixty months.

Signed: date 7.25.00

Improvement Permit by: RS date 7/27/00

Authorization to Construct by: RS date 7/27/00

Installed by: Advance Backhoe

Operation Permit by: RS date 10/5/2000

Existing System Inspection by: date

HEALTH DEPT. COPY: WHITE OWNER COPY (FINAL): YELLOW OWNER COPY (INITIAL): PINK