IREDELL COUNTY HEALTH DEPARTMENT

STATESVILLE 704-878-5305 MOORESVILLE 704-664-5281

175.00 Paid

IMPROVEMENT PERMIT / AUTHORIZATION TO CONSTRUCT / OPERATION PERMIT / EXISTING SYSTEM INSPECTION

PERMIT# 089100 PIN# ~~4669003656 PT~~ 4668-09-9522 DATE 10/29/01

OWNER OR CONTRACTOR KFS INVESTMENTS PHONE: Business 664-3671 Home

ADDRESS 149 YACHT COVE LN MOORESVILLE NC 28115

LOCATION 115N- TR STENNVILLE- TL BROOKGLEN- 2ND ON RT

SUBDIVISION BROOKGLEN BLOCK / SECTION 1 LOT 5 LOT AREA .54AC SITE CLASS. PS DESIGN FLOW 360 GPD L.T.A.R. .25 GPD/FT²

Septic Tank: 1000 Gallons; STB 1017 Date 11-14-01
Pump Tank: _____ Gallons; PT _____ Date _____
Pump Make: _____ Model _____ Serial No. _____
Nitrification Field: No Fields 1 Square Feet 1080 Linear Feet 360
No Lines 6@60' Trench Width 36" Max Trench Bottom Depth 36" Gravel Depth N/A

☑ New System ☐ Repair System Type: I, II, III, IV, V, VI
System Description: GRAVITY 25% REDUCTION
Repair System Description: ~~CONVE~~ LPPANEL
Maintenance Agreement Required: ☐ Yes ☐ No

☑ House/Mod. Home No. Bedrooms 3
☐ Mobile Home No. Bathrooms 2
☐ Business No. Employees ____
☐ Other _____
☐ Slab ☑ Crawl Space ☐ Basement w/plumbing ☐ Basement wo/plumbing

Water Supply:
☑ Individual
☐ Public
☐ Community
OFFSITE WELL


Comments:/Conditions:

72
5
30

Comments:/Conditions: (5@72' INSTALLED)

INSTALLED 48" TRENCH BOTTOM
SOIL NOTES INDICATE SOILS O.K.

INITIAL SITE SKETCH 1" = 50'

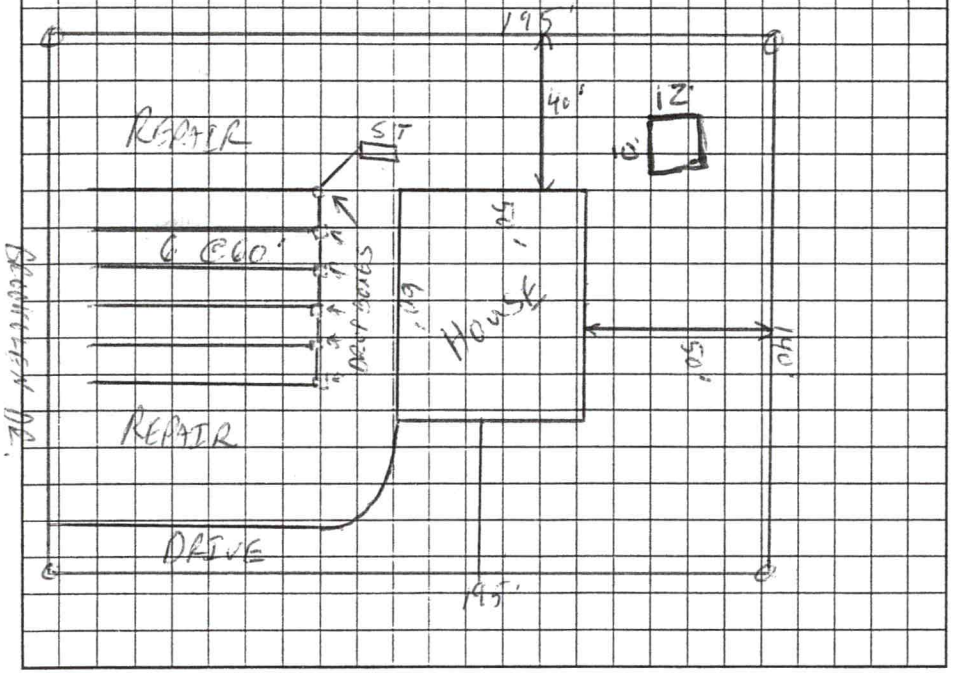

AS BUILT SKETCH

The proposed / existing SHED addition does not appear to impact the existing septic system.
**NOTE: _____ R.S.
Date: 9-15-01
ICHD-Environmental Health Division

Permit can be suspended or revoked if any false information is supplied toward securing the permit/any unauthorized changes are made to the site/any unauthorized changes are made in the installation of the system. Improvement Permit with plat valid without expiration. Improvement Permit with site plan valid for sixty months. Authorization to Construct is valid for a period equal to that of Improvement Permit – not to exceed sixty months.

Signed: _____ date 10/30/01

Improvement Permit by: _____ date 10/29/01

Authorization to Construct by: _____ date 10/30/01

Installed by: TOMMY FRYE

Operation Permit by: _____ date 11/7/02

Existing System Inspection by: _____ date _____