4668113072

IREDELL COUNTY HEALTH DEPARTMENT

STATESVILLE 704-878-5305 MOORESVILLE 704-664-5281

IMPROVEMENT PERMIT / CERTIFICATE OF COMPLETION / OPERATION PERMIT / EXISTING SYSTEM INSPECTION

PROPERTY DESCRIPTION NO. N/A LARRY DATE 6/15/93 TAX MAP NO. N/A

OWNER OR CONTRACTOR MR. SHIRLEY PHONE: Business Home

ADDRESS WIGHTMAN CIR MOORESVILLE

LOCATION 150E, TL ON GOODWIN TR ON WIGHTMAN, TO HOUSE STRAIGHT AHEAD IN CURVE

SUBDIVISION N/A BLOCK / SECTION LOT LOT AREA EXISTING SITE CLASS. P. L.T.A.R. .25

Water Supply: ☑ Individual ☐ Community ☐ Public

Septic Tank: 1000 Gallons; STB N/A Date EXISTING

Pump Tank: Gallons; PT Date

Nitrification Field: No Fields 1 Square Feet 1000 Linear Feet 300

No Lines 3 Trench Width 10' Trench Depth 36" Gravel Depth 12-14"

☐ New System ☑ Repair System Type: I, II, III, IV, V, VI

System Description: CONVENTIONAL

Repair System Description:

Maintenance Agreement Required: ☐ Yes ☐ No

☑ House/Mod. Home ☐ Mobile Home ☐ Business ☐ Other

No. Bedrooms 3 No. Bathrooms 2 No. Employees

☐ Slab ☑ Crawl Space ☐ Basement w/plumbing ☐ Basement wo/plumbing

Garbage Disposal: ☐ Yes ☑ No


Auto. Dishwasher: ☑ Yes ☐ No

Auto. Washing Machine: ☑ Yes ☐ No


Other

Comments USING EXISTING SPACE - TO AVOID PUMPING OF THE SYSTEM
SANITARY T REPLACED - MISSING FROM OLD TANK / BALL RUN VALVE INSTALLED

INITIAL SITE SKETCH

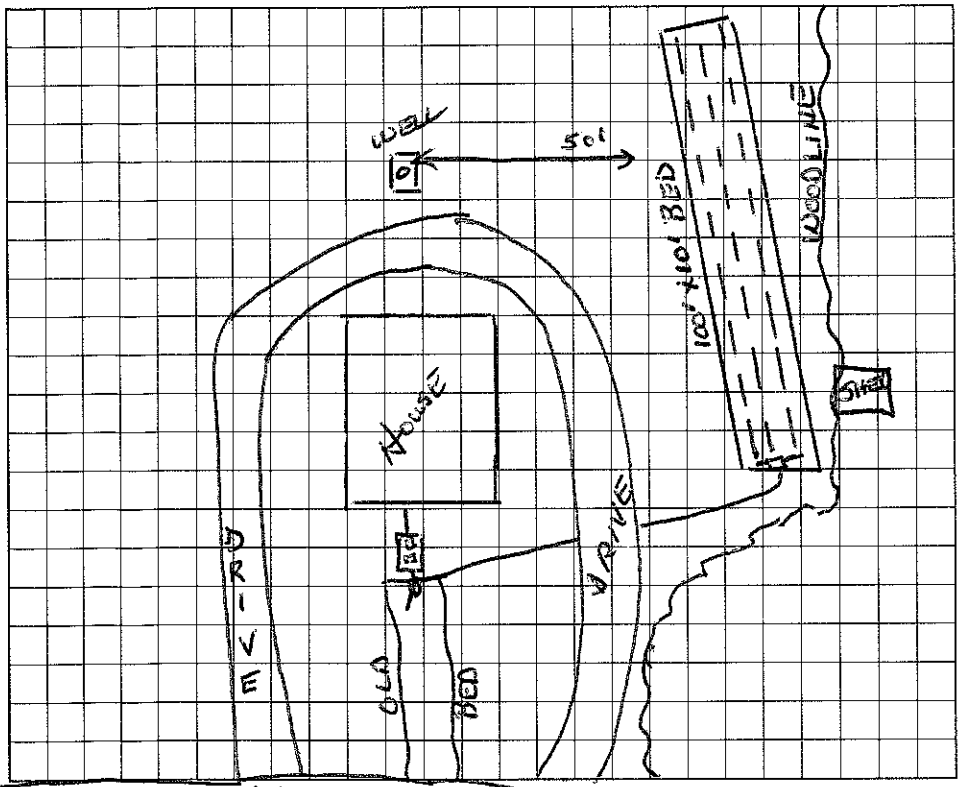

AS BUILT SKETCH

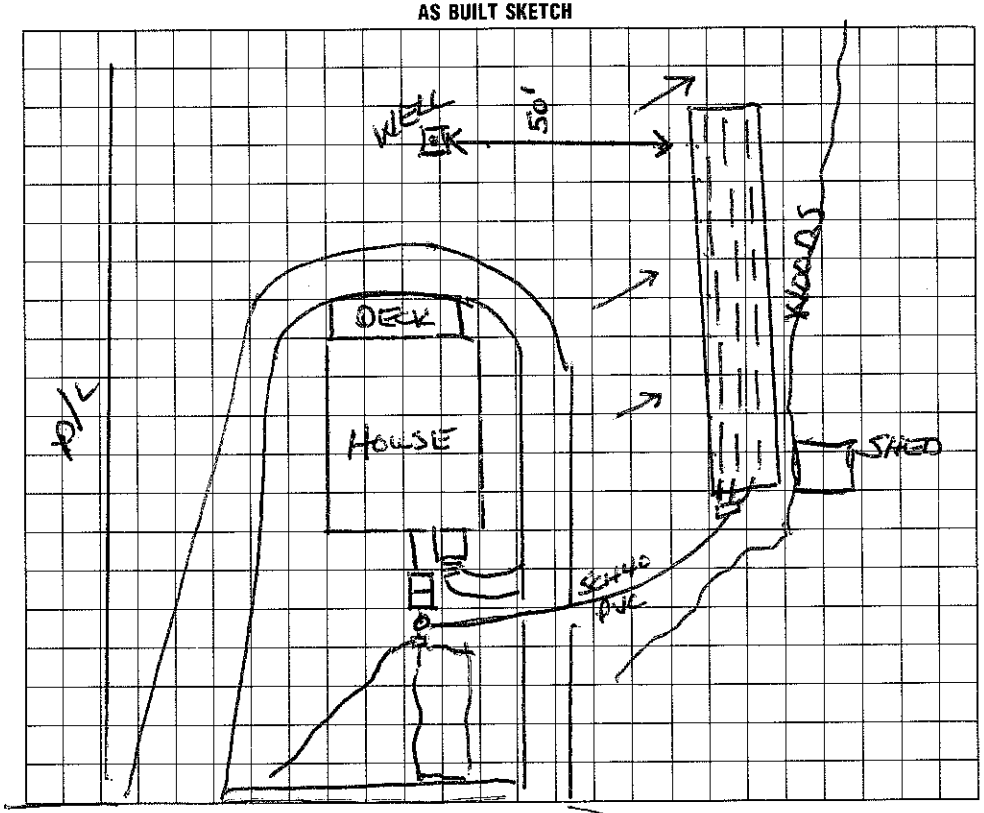

I understand that this permit can be suspended or revoked if any false information is supplied toward securing the permit/any unauthorized changes are made to the site/any unauthorized changes are made in the installation of the system. Improvement Permit is valid for 60 months from date of issuance.

Signed:

Improvement Permit by: Wesley Sparks R.S. date 6/15/93

Existing System Inspection by: date

Installed by: Kelly Parker - Burden Brothers (WIGHTMAN CIR.)

Certificate of Completion by: Wesley Sparks R.S. date 6/18/93

Operation Permit by: date

HEALTH DEPT. COPY: WHITE INSPECTION COPY (FINAL): GREEN OWNER COPY (FINAL): YELLOW INSPECTION COPY (INITIAL): PINK OWNER COPY (INITIAL): GOLD