4668 13 3700

IREDELL COUNTY HEALTH DEPARTMENT

STATESVILLE 704-878-5305 MOORESVILLE 704-664-5281

IMPROVEMENT PERMIT / CERTIFICATE OF COMPLETION / OPERATION PERMIT / EXISTING SYSTEM INSPECTION

PROPERTY DESCRIPTION NO. N/A DATE 6/10/93 TAX MAP NO. N/A

OWNER OR CONTRACTOR WAYNE WILSON PHONE: Business Home 664-1967

ADDRESS Rt 5 Box 941 Mooresville, NC.

LOCATION Mazeppa Rd., 1st House on (L)

SUBDIVISION N/A BLOCK / SECTION LOT LOT AREA EXISTING SITE CLASS. P L.T.A.R. .25 - .3

Water Supply: ☑ Individual ☐ Community ☐ Public

Septic Tank: 1000 Gallons; STB Date

Pump Tank: Gallons; PT Date

Nitrification Field: No Fields 2 Square Feet 600 Linear Feet 200

No Lines 4 Trench Width 3' Trench Depth 36" Gravel Depth 12"

☐ New System ☑ Repair System Type: I, II, (II), IV, V, VI

System Description: Conv.

Repair System Description: Conv.

Maintenance Agreement Required: ☐ Yes ☑ No

☑ House/Mod. Home No. Bedrooms 3 Garbage Disposal: ☑ Yes ☐ No

☐ Mobile Home No. Bathrooms 2.5 Auto. Dishwasher: ☑ Yes ☐ No


☐ Business No. Employees Auto. Washing Machine: ☑ Yes ☐ No

☐ Other Other


☐ Slab ☐ Crawl Space ☑ Basement w/plumbing ☐ Basement wo/plumbing

Comments Soil is dull red-brown in lower laterals shaw evidence of gray relic mottling, of wk to massive coarse sbk saprolite clay skins between rds/fracture lines. Trench depth is 18-20" surface soil has mod to wk mod sbk structure, soil dry though it rained this morning. Non biodegradable items in septic tank. Newton (A.L.)

INITIAL SITE SKETCH

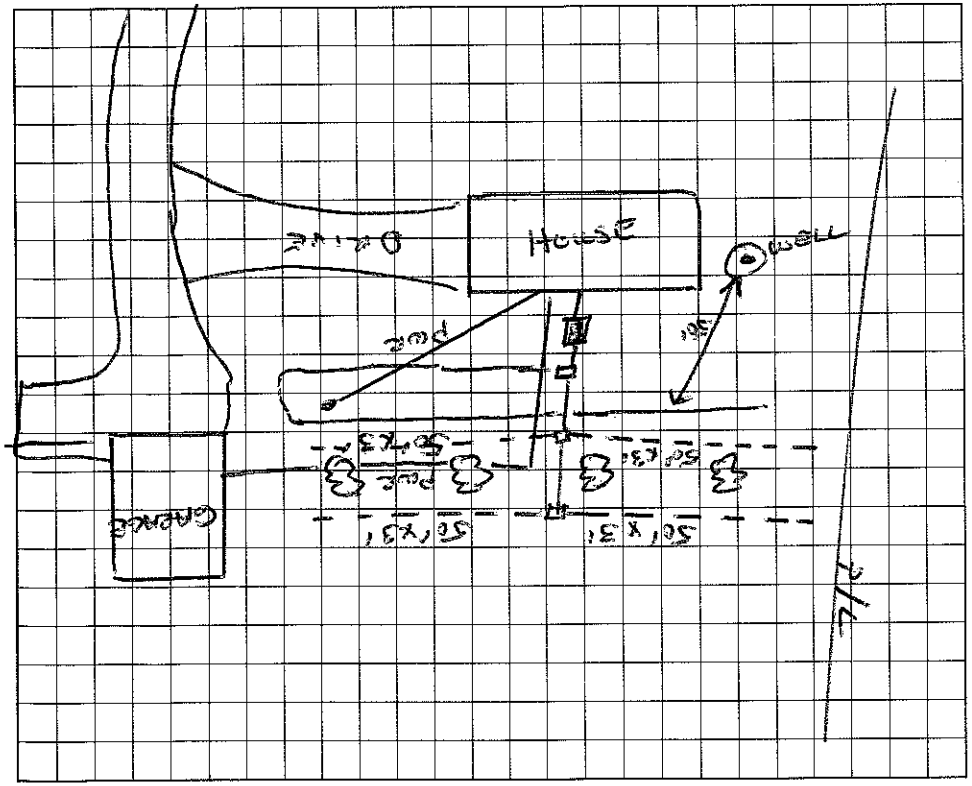

AS BUILT SKETCH

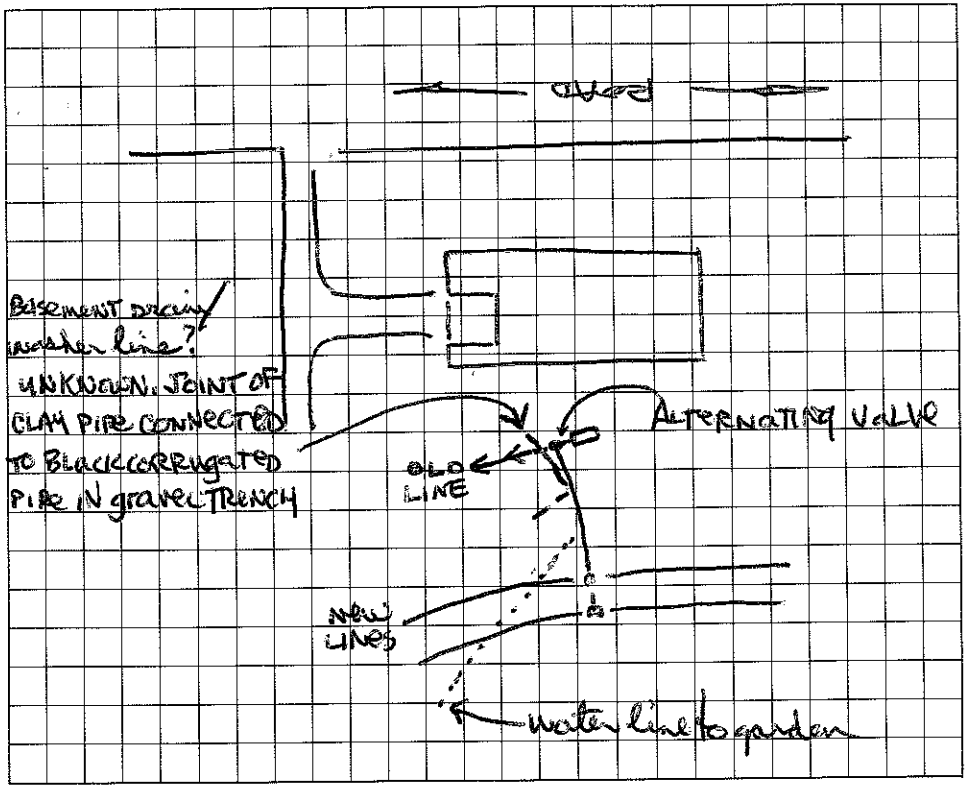

I understand that this permit can be suspended or revoked if any false information is supplied toward securing the permit/any unauthorized changes are made to the site/any unauthorized changes are made in the installation of the system. Improvement Permit is valid for 60 months from date of issuance.

Signed:

Improvement Permit by: Wesley Sparks RS. date 6/10/93

Existing System Inspection by: date

Installed by:

Certificate of Completion by: Andrea Lemon date 8-13-93

Operation Permit by: date

HEALTH DEPT. COPY: WHITE INSPECTION COPY (FINAL): GREEN OWNER COPY (FINAL): YELLOW INSPECTION COPY (INITIAL): PINK OWNER COPY (INITIAL): GOLD