Authorization to Construct 466813506 l

IREDELL COUNTY HEALTH DEPARTMENT

STATESVILLE 704-878-5305 MOORESVILLE 704-664-5281

IMPROVEMENT PERMIT / CERTIFICATE OF COMPLETION / OPERATION PERMIT / EXISTING SYSTEM INSPECTION

PROPERTY DESCRIPTION NO. 4003 DATE 7/2/96 TAX MAP NO. 1MA 27 Watershed: ☐ Yes ☒ No

OWNER OR CONTRACTOR Mark Strazzabosco PHONE: Business ______ Home 662-3055

ADDRESS 211 W Stewart St Mooresville NC 28115

LOCATION 115 N TR on Mazeppa TR on Stafford Lane lot on (R) past first house on (R)

SUBDIVISION N/A BLOCK / SECTION ______ LOT 27 LOT AREA ~26,000 SITE CLASS. PS DESIGN FLOW 360 L.T.A.R. .325

Septic Tank: 1000 Gallons; STB 794 Date 2/8/96

Pump Tank: ______ Gallons; PT ______ Date ______

Pump Make: ______ Model ______ Serial No. ______

Nitrification Field: No Fields 1 Square Feet 1107 Linear Feet 369

No Lines 4 Trench Width 36" Max Trench Bottom Depth 36" Gravel Depth 12"

☒ New System ☐ Repair System Type: I, (II), III, IV, V, VI

System Description: DIST BOX - CONV.

Repair System Description: CH PLASTIC

Maintenance Agreement Required: ☐ Yes ☒ No

☒ House/Mod. Home ☐ Mobile Home ☐ Business ☐ Other ______

No. Bedrooms 3 No. Bathrooms 2.5 No. Employees ______


Water Supply: ☒ Individual ☐ Community ☐ Public

☐ Slab ☒ Crawl Space ☐ Basement w/plumbing ☐ Basement wo/plumbing

Comments: 369 feet of conventional drainfield location of home from R/W critical

Comments:

INITIAL SITE SKETCH

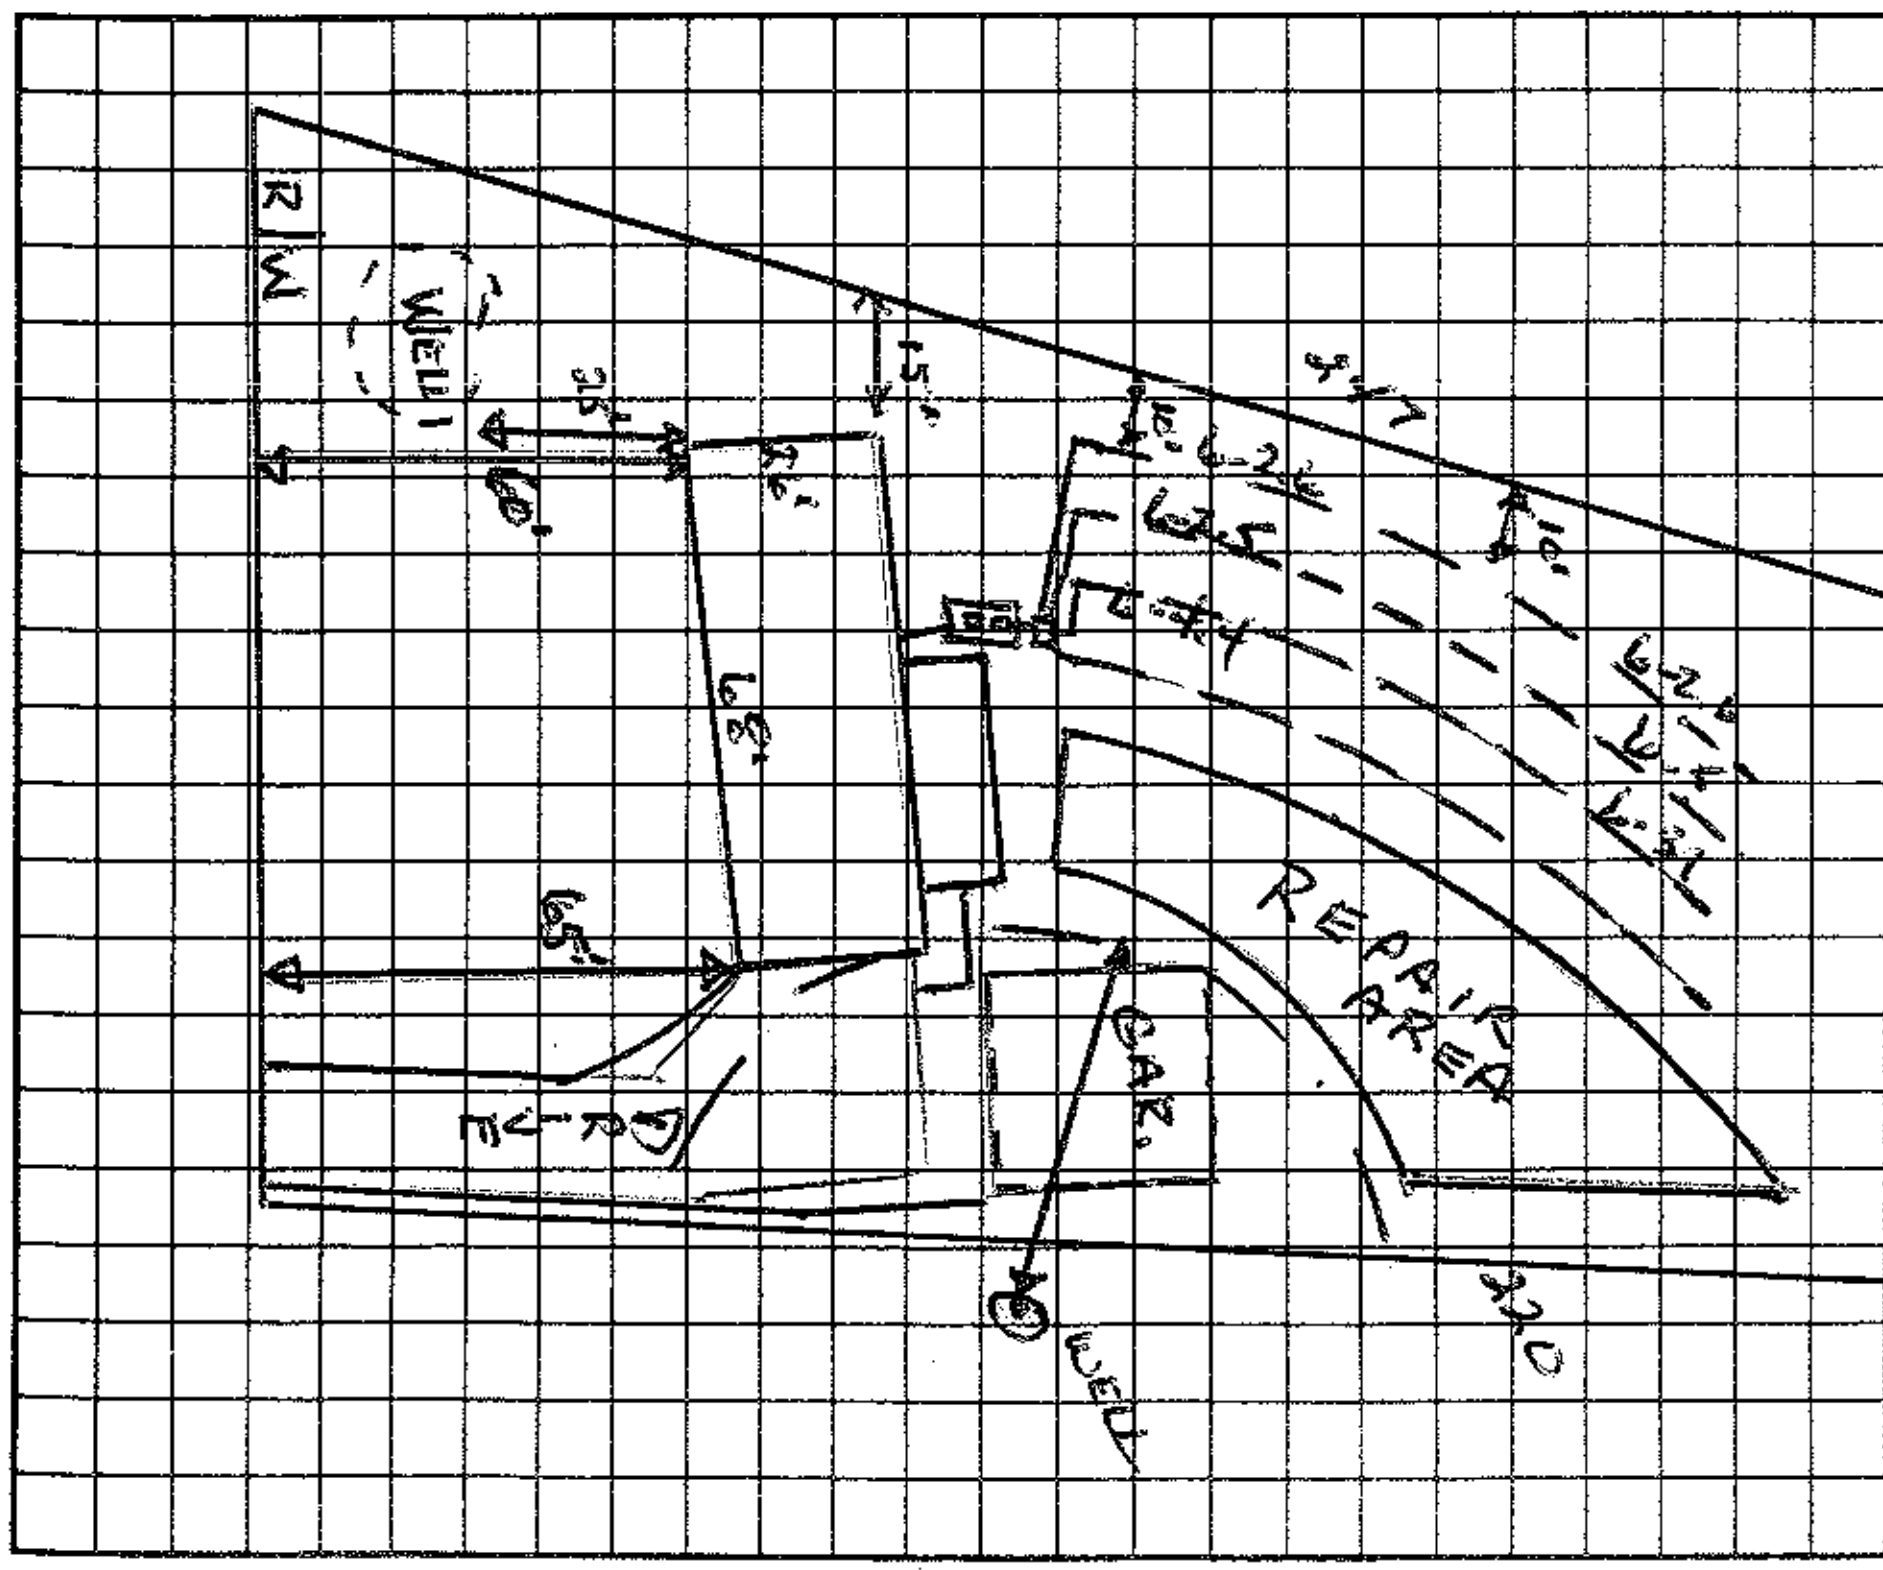

AS BUILT SKETCH

I understand that this permit can be suspended or revoked if any false information is supplied toward securing the permit/any unauthorized changes are made to the site/any unauthorized changes are made in the installation of the system.

Authorization to Construct valid 60 months.

Signed: * [signature]

Improvement Permit by: Wesley Sparks RS. date 7/2/96

Existing System Inspection by: Wesley Sparks RS. date 7/2/96

Installed by: Colyco - Denver

Certificate of Completion by: ______ date ______

Operation Permit by: Wesley Sparks RS date 8/23/96

HEALTH DEPT. COPY: WHITE INSPECTION COPY (FINAL): GREEN OWNER COPY (FINAL): YELLOW INSPECTION COPY (INITIAL): PINK OWNER COPY (INITIAL): GOLD