IREDELL COUNTY HEALTH DEPARTMENT

Existing System

STATESVILLE 704-878-5305 MOORESVILLE 704-664-5281

IMPROVEMENT PERMIT / AUTHORIZATION TO CONSTRUCT / OPERATION PERMIT / EXISTING SYSTEM INSPECTION

PERMIT# 146836 PIN# 4668298677.000 DATE 12/6/07

OWNER OR CONTRACTOR Fred Wright PHONE: Business 704 892-3273 Home

ADDRESS 120 Wrights Haven, Mooresville NC 28115

LOCATION Hwy 21 N TR Shinnville Rd. TR Pond View TR Rebel Hill Rd. on Right near end of road before it curves

SUBDIVISION N/A BLOCK / SECTION LOT LOT AREA acreage SITE CLASS. PS DESIGN FLOW 240 L.T.A.R. Exis

Septic Tank: 1000 Exis Gallons; STB Date

Pump Tank: Gallons; PT Date

Pump Make: Model Serial No.

Nitrification Field: No Fields 1 Square Feet 400 Exis Linear Feet 300' Exis

No Lines 4@75' Trench Width 36" Max Trench Bottom Depth 36"

☐ New System ☐ Repair System Type: I (II) III, IV, V, VI

System Description: Existing System

Repair System Description:

Maintenance Agreement Required: ☐ Yes ☐ No

☐ House/Mod. Home No. Bedrooms 2

☑ Mobile Home No. Bathrooms

☐ Business No. Employees

☐ Other

Water Supply: ☑ Individual ☐ Public ☐ Community


Gravel Depth Exis ☐ Slab ☒ Crawl Space ☐ Basement w/plumbing ☐ Basement wo/plumbing

Comments:/Conditions:

Comments:/Conditions: * No visible malfunction observed of Existing septic System System is sized for a 3 Bedroom MH. applicant is placing a 2BR Home. Stay 5' min from Exis septic Tank & drainlines with Home.

INITIAL SITE SKETCH

AS BUILT SKETCH

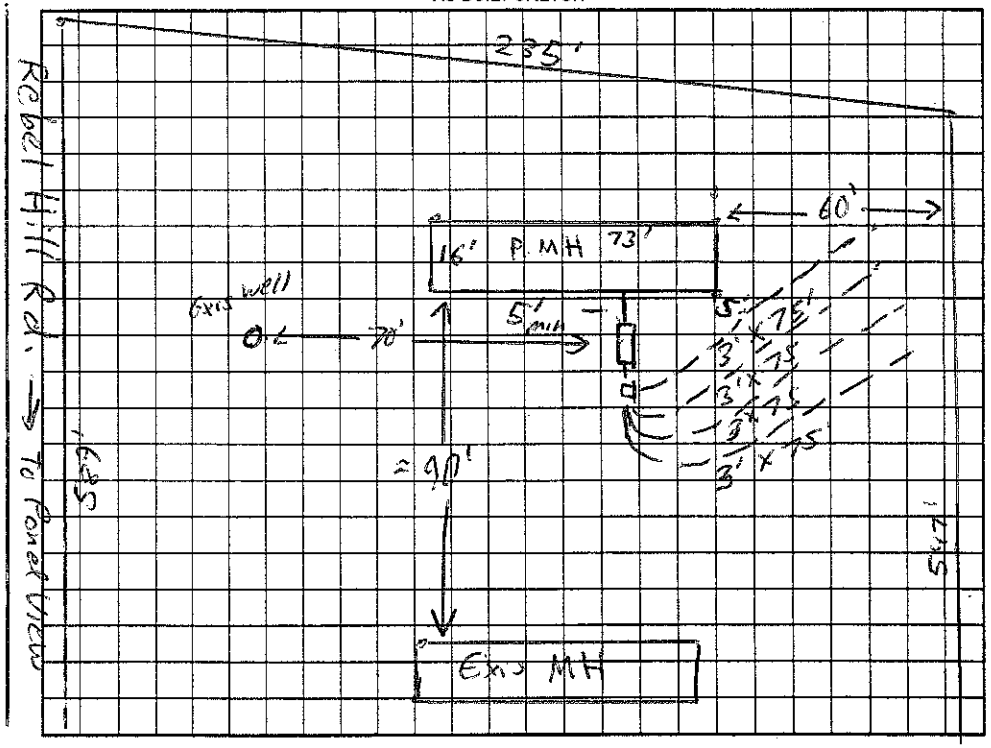

Permit can be suspended or revoked if any false information is supplied toward securing the permit/any unauthorized changes are made to the site/any unauthorized changes are made in the installation of the system. Improvement Permit with plat valid without expiration. Improvement Permit with site plan valid for sixty months. Authorization to Construct is valid for a period equal to that of Improvement Permit – not to exceed sixty months.

Signed: Tony Perkins date 12 6 07 Installed by:

Improvement Permit by: date Operation Permit by: date

Authorization to Construct by: date Existing System Inspection by: Anthony Coleman Jr date 12/6/07

HEALTH DEPT. COPY: WHITE OWNER COPY (FINAL): YELLOW OWNER COPY (INITIAL): PINK