4668391280

IREDELL COUNTY HEALTH DEPARTMENT

STATESVILLE 704-878-5305 MOORESVILLE 704-664-5281

IMPROVEMENT PERMIT / CERTIFICATE OF COMPLETION / OPERATION PERMIT / EXISTING SYSTEM INSPECTION

PROPERTY DESCRIPTION NO. 20762 DATE 4/5/95 TAX MAP NO. 10 A 8 Watershed: ☐ Yes ☒ No

OWNER OR CONTRACTOR Charles K Moore PHONE: Business _____ Home 664-5587

ADDRESS 1427 N Main St. Mooresville, NC. 28115

LOCATION Shinnville Rd. 1 mile TR on gravel drive to 1st (R) off drive to mobile home in field

SUBDIVISION _____ BLOCK / SECTION _____ LOT _____ LOT AREA ~44 Ac SITE CLASS. A DESIGN FLOW 240 L.T.A.R. .35

Septic Tank: 1000 Gallons; STB _____ Date _____

Pump Tank: _____ Gallons; PT _____ Date _____

Pump Make: _____ Model _____ Serial No. _____

Nitrification Field: No Fields 1 Square Feet 685 Linear Feet 240

No Lines 1 X 2 Trench Width 36" Max Trench Bottom Depth 36" Gravel Depth 12"

☒ New System ☐ Repair System Type: I, ☒ II, III, IV, V, VI

System Description: COND - DIST BOX

Repair System Description: _____

Maintenance Agreement Required: ☐ Yes ☐ No

☐ House/Mod. Home No. Bedrooms 2

☒ Mobile Home D/W No. Bathrooms 2

☐ Business No. Employees _____

☐ Other _____


☐ Slab ☒ Crawl Space ☐ Basement w/plumbing ☐ Basement wo/plumbing

Water Supply: ☒ Individual ☐ Community ☐ Public

Comments:

Comments:
6/21/95 Changed with L Beam on site. BWS.

INITIAL SITE SKETCH

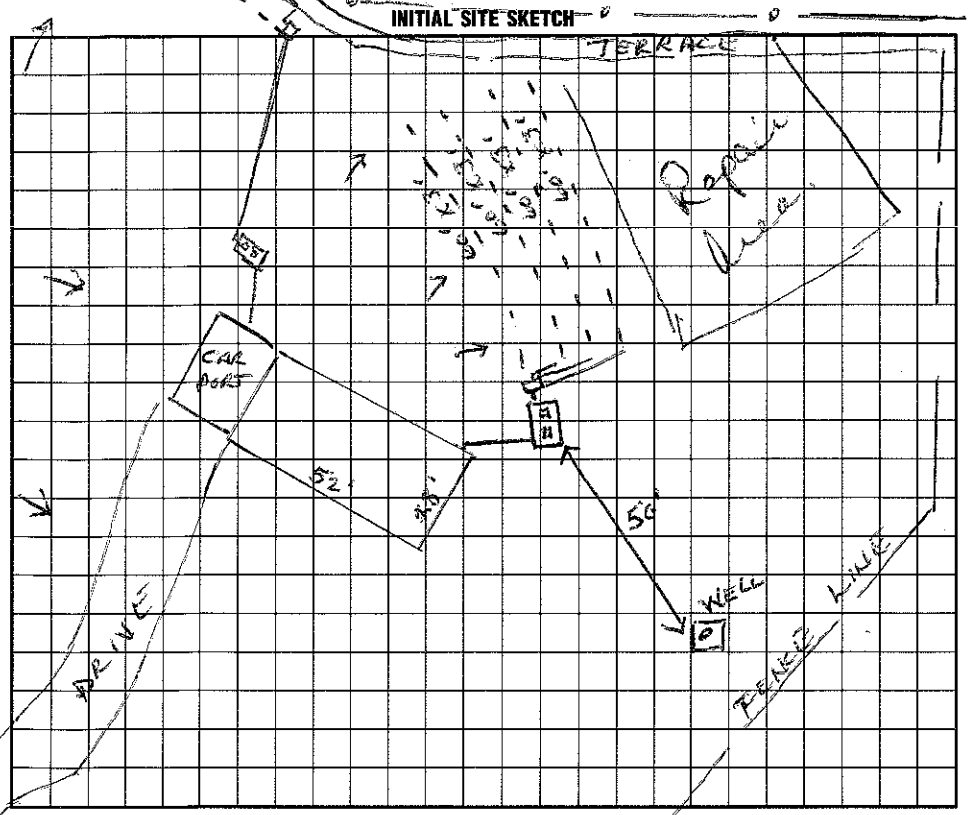

AS BUILT SKETCH

I understand that this permit can be suspended or revoked if any false information is supplied toward securing the permit/any unauthorized changes are made to the site/any unauthorized changes are made in the installation of the system. Improvement Permit is valid for 60 months from date of issuance.

Signed: + Charles K Moore

Improvement Permit by: Wesley Sparks RS date 4/5/95

Existing System Inspection by: _____ date _____

Installed by: Larry Beam

Certificate of Completion by: Wesley Sparks RS. date 7/25/95

Operation Permit by: _____ date _____

HEALTH DEPT. COPY: WHITE INSPECTION COPY (FINAL): GREEN OWNER COPY (FINAL): YELLOW INSPECTION COPY (INITIAL): PINK OWNER COPY (INITIAL): GOLD