IREDELL COUNTY HEALTH DEPARTMENT

STATESVILLE 704-878-5305 MOORESVILLE 704-664-5281

IMPROVEMENT PERMIT / CERTIFICATE OF COMPLETION / OPERATION PERMIT / EXISTING SYSTEM INSPECTION

PROPERTY DESCRIPTION NO. 3117 DATE 6/5/95 TAX MAP NO. 7IMA-17 Watershed: [X] Yes [ ] No

OWNER OR CONTRACTOR Dennis Shea PHONE: Business 4606840455 Home 662-3679

ADDRESS 266 S Main St Mooresville, NC 28115

LOCATION 150 E TR ON WAGENHEER RD. PROPERTY IMMEDIATELY ON (R) CORNER 754 Oakridge Farm Hwy

SUBDIVISION N/A BLOCK / SECTION LOT LOT AREA 5.7 AC SITE CLASS. PS DESIGN FLOW 400 L.T.A.R. .15

Septic Tank: 1500 Gallons; STB Date

Pump Tank: 1000 Gallons; PT Date

Pump Make: Model Serial No.

Nitrification Field: No Fields 1 Square Feet 2666 Linear Feet 533

No Lines 8 Trench Width 12" Max Trench Bottom Depth 16" Gravel Depth 6"

[X] New System [ ] Repair System Type: I, II, III, (IV) V, VI

System Description: LPP - SEE ENG. SITE PLAN - SPECS

Repair System Description: SAME

Maintenance Agreement Required: [X] Yes [ ] No

[X] House/Mod. Home No. Bedrooms 3

[ ] Mobile Home No. Bathrooms 2

[X] Business No. Employees 1

[ ] Other

[ ] Slab [X] Crawl Space [ ] Basement w/plumbing [ ] Basement wo/plumbing


Water Supply: [X] Individual [ ] Community [ ] Public

Comments: DO NOT ATTEMPT INSTALLATION WITHOUT HAVING ENGINEERS SITE PLAN AND SPECS ON SITE FOR REFERENCE


SELMA-RD Selma Rd

Comments:

INITIAL SITE SKETCH

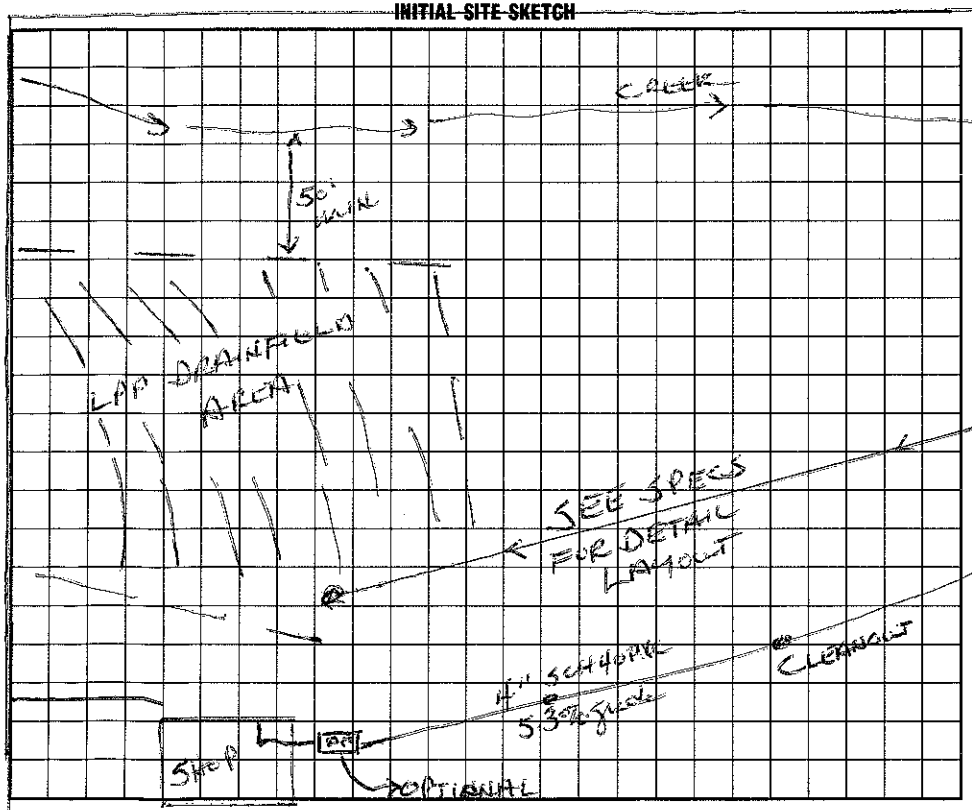

AS BUILT SKETCH

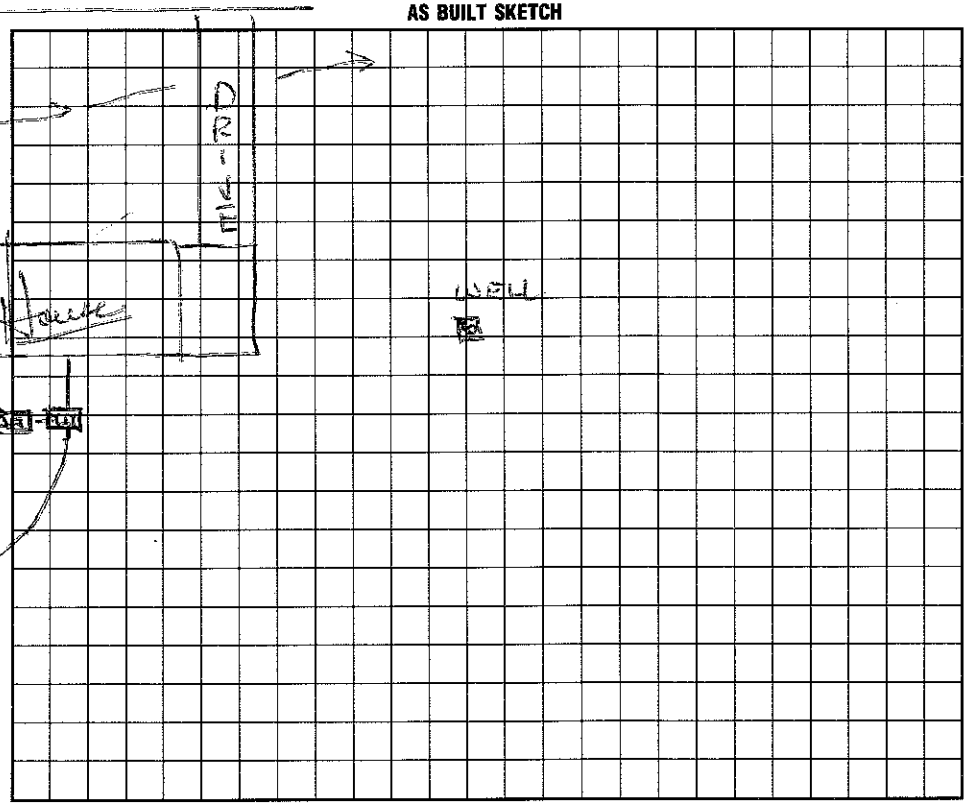

I understand that this permit can be suspended or revoked if any false information is supplied toward securing the permit/any unauthorized changes are made to the site/any unauthorized changes are made in the installation of the system. Improvement Permit is valid for 60 months from date of issuance.

Signed: [signature]

Improvement Permit by: Wesley Sparks R.S. date 6/5/95

Existing System Inspection by: date

Installed by: Julian Bowles

Certificate of Completion by: Wesley Sparks R.S. date 12/27/95

Operation Permit by: Wesley Sparks R.S. date 12/27/95

HEALTH DEPT. COPY: WHITE INSPECTION COPY (FINAL): GREEN OWNER COPY (FINAL): YELLOW INSPECTION COPY (INITIAL): PINK OWNER COPY (INITIAL): GOLD