4668 41 2380

...L COUNTY HEALTH DEPARTMENT

STATESVILLE 704-878-5305 MOORESVILLE 704-664-5281

...ROVEMENT PERMIT / CERTIFICATE OF COMPLETION / OPERATION PERMIT / EXISTING SYSTEM INSPECTI

PROPERTY DESCRIPTION NO. 5038 DATE 8/25/97 TAX MAP NO. 4674121289

OWNER OR CONTRACTOR Grace Community Church PHONE: Business 662-9610 Home Watershed: X Yes

ADDRESS 753 Ochridge Rd. Mooresville, NC. 28115

LOCATION 115 N TR 150 on (L) just before Overhead Bridge Rd

SUBDIVISION No BLOCK / SECTION LOT LOT AREA ~23Ac SITE CLASS PS DESIGN FLOW 500GPD L.T.A.R. .125

Septic Tank: 1500 Gallons; STB 791 Date 3/5/99

~~Pump Tank:~~ (EXISTING) Gallons; PT Date

Pump Make: Model 1332 Serial No. 444

Nitrification Field: No Fields Square Feet ~~454~~ Linear Feet ~~333~~

No Lines 4 Trench Width 36" Max Trench Bottom Depth 36" Gravel Depth 12"

X New System ☐ Repair System Type: I, II, (III) IV, V, VI

System Description: Addition to System

Repair System Description:

Maintenance Agreement Required: ☐ Yes X No

☐ House/Mod. Home No. Bedrooms

☐ Mobile Home No. Bathrooms

☐ Business No. Employees

X Other CHURCH FELLOWSHIP


X Slab ☐ Crawl Space ☐ Basement w/plumbing ☐ Basement wo/plumbing

Water Supply
X Individual
☐ Community
☐ Public


Comments: (1) ADD FLOW-DIVIDER BETWEEN EXISTING D/B AND S/T (2) SET LOWER NEW D/B (3) PLUMB LOWEST ENSTING LINE AND 3 NEW LINES OUT OF NEW (LOWEST) D/B. (4) INSTALL 3 NEW LINES.

Comments: (60 TOTAL DAY CARE + SCHOOL - 8/2/99 AWS)

INITIAL SITE SKETCH

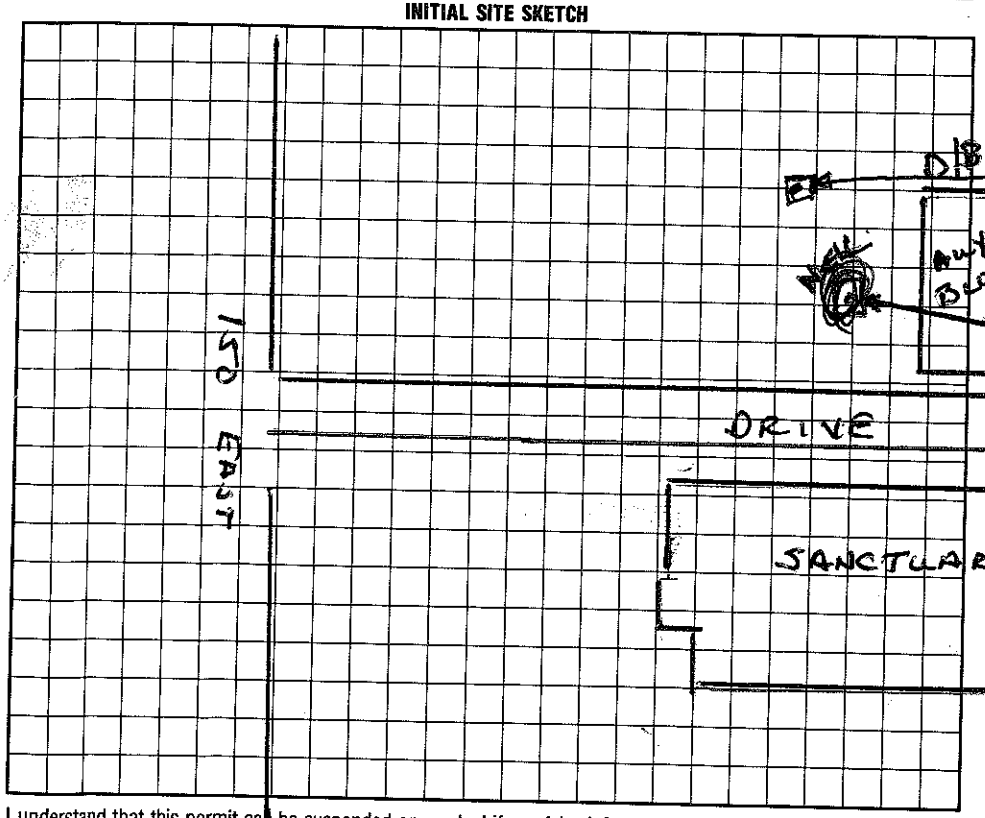

AS BUILT SKETCH

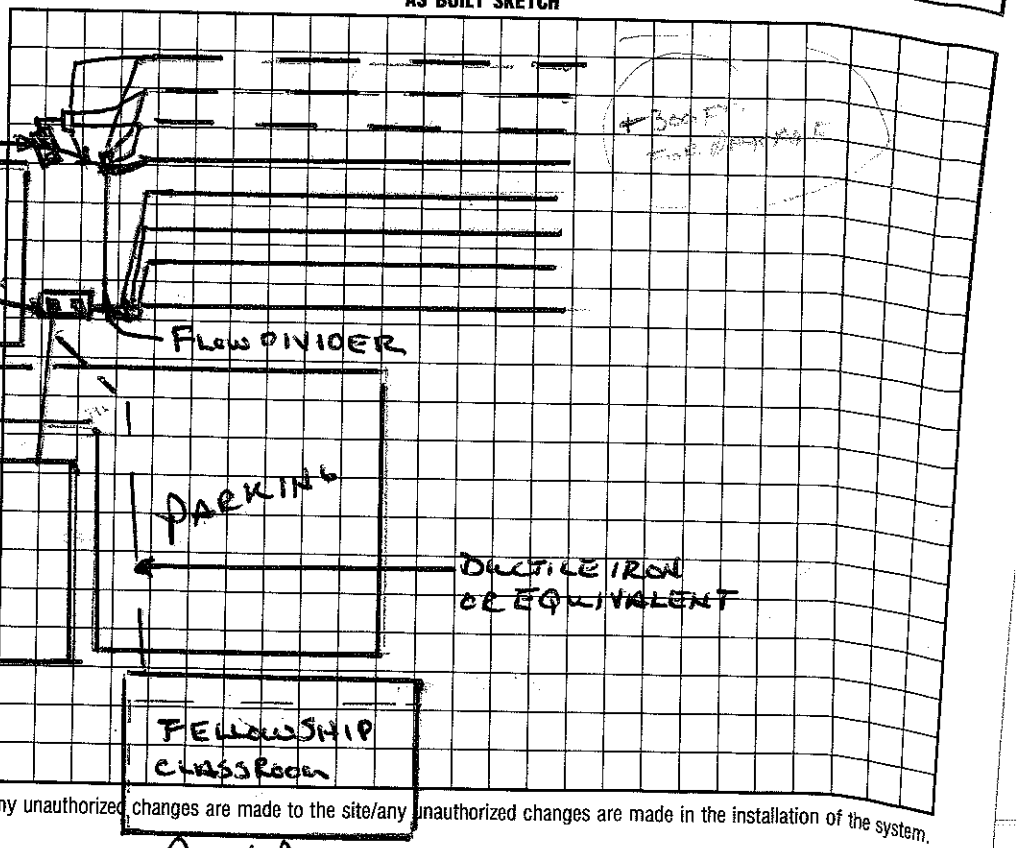

I understand that this permit can be suspended or revoked if any false information is supplied toward securing the permit/any unauthorized changes are made to the site/any unauthorized changes are made in the installation of the system. Improvement Permit is valid for 60 months from date of issuance.

Signed: ~~X~~ Mark E. Hartley

Improvement Permit by: Wesley Sparks R.S. date 8/25/97

~~Existing System Inspection~~ by: Wesley Sparks R.S. date 8/25/97

Installed by: Curt Dunning

Certificate of Completion by: date

Operation Permit by: Wesley Sparks R.S. date 6/3/99

HEALTH DEPT. COPY: WHITE | INSPECTION COPY (FINAL): GREEN | OWNER COPY (FINAL): YELLOW | INSPECTION COPY (INITIAL): PINK | OWNER COPY (INITIAL): GOLD