IREDELL COUNTY HEALTH DEPARTMENT

STATESVILLE 704-878-5305 MOORESVILLE 704-664-5281

IMPROVEMENT PERMIT / CERTIFICATE OF COMPLETION / OPERATION PERMIT / EXISTING SYSTEM INSPECTION

PROPERTY DESCRIPTION NO. 3677 DATE 1/19/96 TAX MAP NO. 1MA5 Watershed: [X] Yes [ ] No

OWNER OR CONTRACTOR Grace Baptist Church PHONE: Business 662-9610 Home

ADDRESS PO Box 1122 Mooresville NC. 28115

LOCATION 150 East on (D) before Overhead Bridge Rd.

SUBDIVISION N/A BLOCK / SECTION LOT LOT AREA 5 ± ACRE SITE CLASS. PS. DESIGN FLOW 500 L.T.A.R. .25

Septic Tank: 1500 Gallons; STB 1014 Date 6/11/94

Pump Tank: Gallons; PT Date

Pump Make: Model Serial No.

Nitrification Field: No Fields 1 Square Feet 1666 Linear Feet 555

No Lines 5 Trench Width 36" Max Trench Bottom Depth 36" Gravel Depth 12"

[X] New System [ ] Repair System Type: [ ] I [ ] II [III] IV [ ] V [ ] VI

System Description: GRAV - CONVENTIONAL

Repair System Description:

Maintenance Agreement Required: [ ] Yes [ ] No

[ ] House/Mod. Home No. Bedrooms

[ ] Mobile Home No. Bathrooms

[ ] Business No. Employees

[X] Other 100 SEAT CHURCH

[✓] Slab [ ] Crawl Space [ ] Basement w/plumbing [ ] Basement wo/plumbing

Water Supply: [X] Individual [ ] Community [ ] Public


Comments: 500 GPD

1/19/96 - ADDITION OF AUX. BLDG. ACCEPTABLE TO THIS SYSTEM


Comments:

REPAIR AREA

INITIAL SITE SKETCH

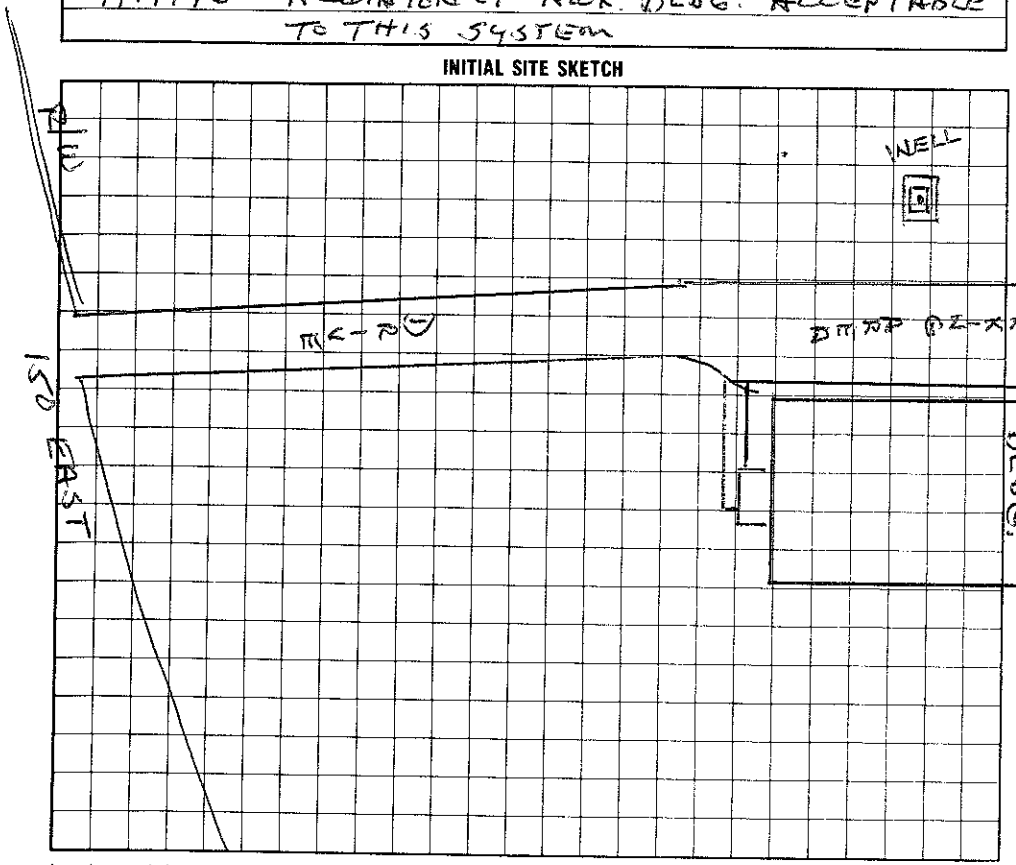

AS BUILT SKETCH

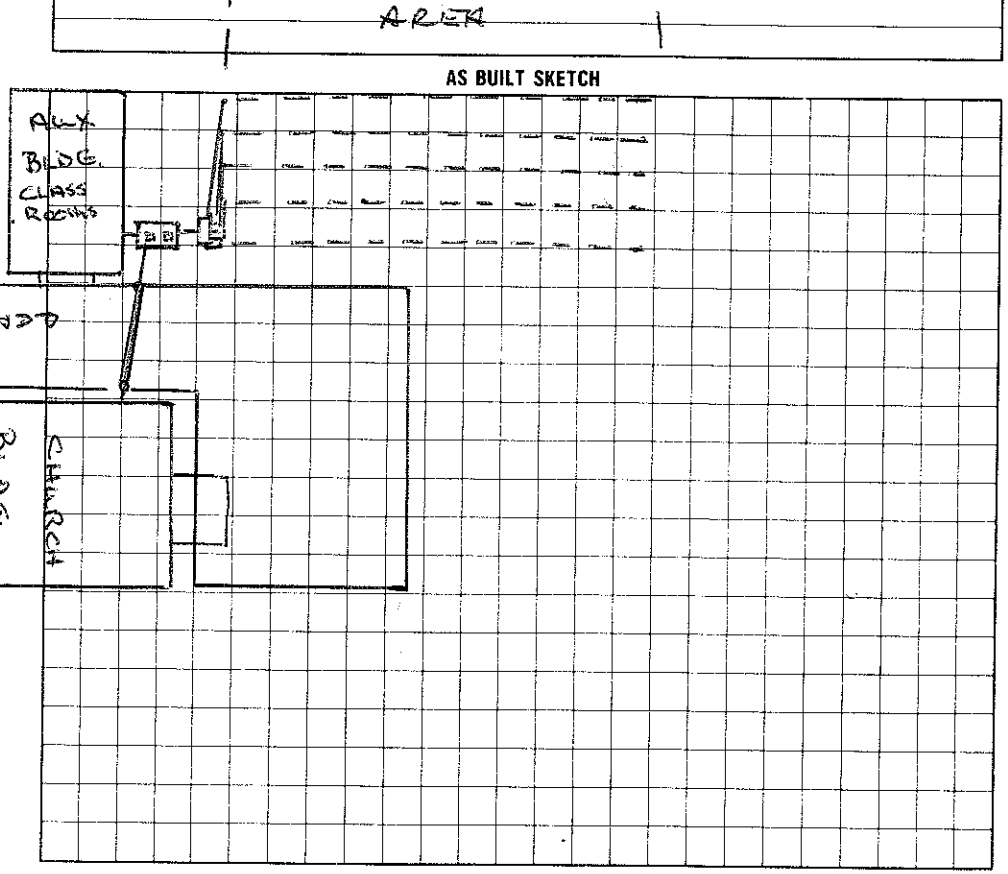

I understand that this permit can be suspended or revoked if any false information is supplied toward securing the permit/any unauthorized changes are made to the site/any unauthorized changes are made in the installation of the system.

Signed:

Improvement Permit by: date

Existing system inspection by: date

Installed by:

Certificate of Completion by: Wesley Sparks RS. date 1/19/96

Operation Permit by: Wesley Sparks RS. date 1/19/96.

HEALTH DEPT. COPY: WHITE INSPECTION COPY (FINAL): GREEN OWNER COPY (FINAL): YELLOW INSPECTION COPY (INITIAL): PINK OWNER COPY (INITIAL): GOLD