Existing System

IREDELL COUNTY HEALTH DEPARTMENT

STATESVILLE 704-878-5305 MOORESVILLE 704-664-5281

IMPROVEMENT PERMIT / AUTHORIZATION TO CONSTRUCT / OPERATION PERMIT / EXISTING SYSTEM INSPECTION

PERMIT# 14858 PIN# 4668499631 704 873 2547 DATE 3/6/08

OWNER OR APPLICANT Walter Wright PHONE: Business Clayton Homes Home

ADDRESS 101 Cedarview Ln. Mooresville NC 28115

LOCATION 115 N TR Mazeppa TL Woodridge TL Cederview Ln. at end on right 101 Cedarview

SUBDIVISION Woodridge BLOCK / SECTION LOT 8 LOT AREA ≈2.56ac SITE CLASS. 5 DESIGN FLOW 360 L.T.A.R.

Exis

Septic Tank: 1000 Gallons: STB Date

Pump Tank: Gallons: PT Date

Pump Make: Model Serial No.

Nitrification Field: No Fields 1 Square Feet ≈900' Linear Feet ≈300' Exis

Exist. No Lines 2 @ 130' Trench Width 36" Max Trench Bottom Depth Exis Gravel Depth Exis

☐ New System ☐ Repair ☐ Expansion System Type: I (II) III IV V VI

System Description: Existing System

Repair System Description:

Maintenance Agreement Required: ☐ Yes ☐ No

☐ House/Mod. Home ☑ Mobile Home ☐ Business ☐ Other

No. Bedrooms 3 No. Persons No. Employees

Water Supply: ☑ Individual Exis ☐ Public ☐ Community


☑ Gravity ☐ Pressure ☐ Slab ☑ Crawl Space ☐ Basement w/plumbing ☐ Basement wo/plumbing

Comments:/Conditions:

Comments:/Conditions: No visible malfunction of Existing System.
NTS (2) 130' lines found.
3BR Mobile home

INITIAL SITE SKETCH

AS BUILT SKETCH

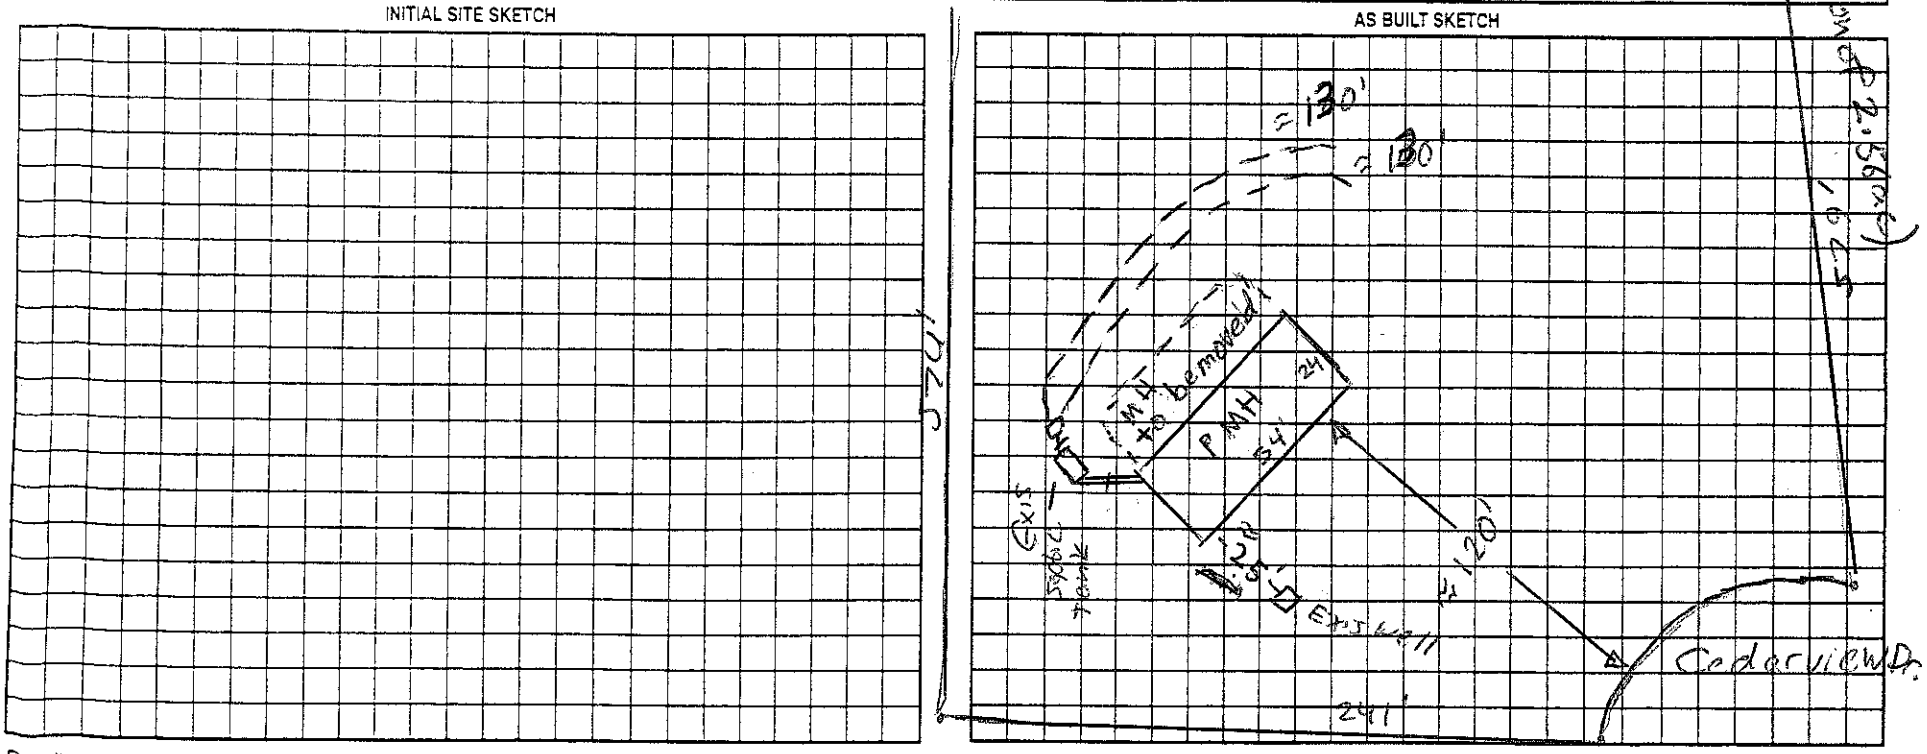

Permit can be suspended or revoked if any false information is supplied toward securing the permit/any unauthorized changes are made to the site/any unauthorized changes are made in the installation of the system. Improvement Permit with plat valid without expiration ☐ Improvement Permit with site plan valid for sixty months ☐ Authorization to Construct is valid for a period equal to that of Improvement Permit – not to exceed sixty months.

Signed: date 3-13-08 Installed by:

Improvement Permit by: date Operation Permit by: date

Authorization to Construct by: date Existing System Inspection by: Anthony Cokenh date 3/10/08

HEALTH DEPT. COPY: WHITE OWNER COPY (FINAL): YELLOW OWNER COPY (INITIAL): PINK