IREDELL COUNTY HEALTH DEPARTMENT

Authorization to Construct 4668510591

STATESVILLE 704-878-5305 MOORESVILLE 704-664-5281

IMPROVEMENT PERMIT / ~~CERTIFICATE OF COMPLETION~~ / OPERATION PERMIT / EXISTING SYSTEM INSPECTION

PROPERTY DESCRIPTION NO. 3562 DATE 11/30/95 TAX MAP NO. 1N 11 A Watershed: [X] Yes [ ] No

OWNER OR CONTRACTOR Brightstar Develop (Mike Henrickson) PHONE: Business _____ Home 663-5261

ADDRESS 232 E Park Ave. Mooresville, NC. 28115

LOCATION Overhead Bridge Rd. on (R) before entrance to Highland Cuesta

SUBDIVISION Highland Cuesta BLOCK / SECTION _____ LOT 29 LOT AREA ~ 1 Ac SITE CLASS. PS DESIGN FLOW 360 L.T.A.R. .3

Septic Tank: 1000 Gallons; STB 794 Date 12/15/95

Pump Tank: _____ Gallons; PT _____ Date _____

Pump Make: _____ Model _____ Serial No. _____

Nitrification Field: No Fields 1 Square Feet 1200 Linear Feet 400

No Lines 5 Trench Width 36" Max Trench Bottom Depth 36" Gravel Depth 12"

[X] New System [ ] Repair System Type: I, (II), III, IV, V, VI

System Description: Conventional

Repair System Description: _____

Maintenance Agreement Required: [ ] Yes [X] No

[X] House/Mod. Home No. Bedrooms 3

[ ] Mobile Home No. Bathrooms 2.5

[ ] Business No. Employees _____

[ ] Other _____


[ ] Slab [X] Crawl Space [ ] Basement w/plumbing [ ] Basement wo/plumbing

Water Supply: [X] Individual [ ] Community [ ] Public


Comments:

Comments:

INITIAL SITE SKETCH

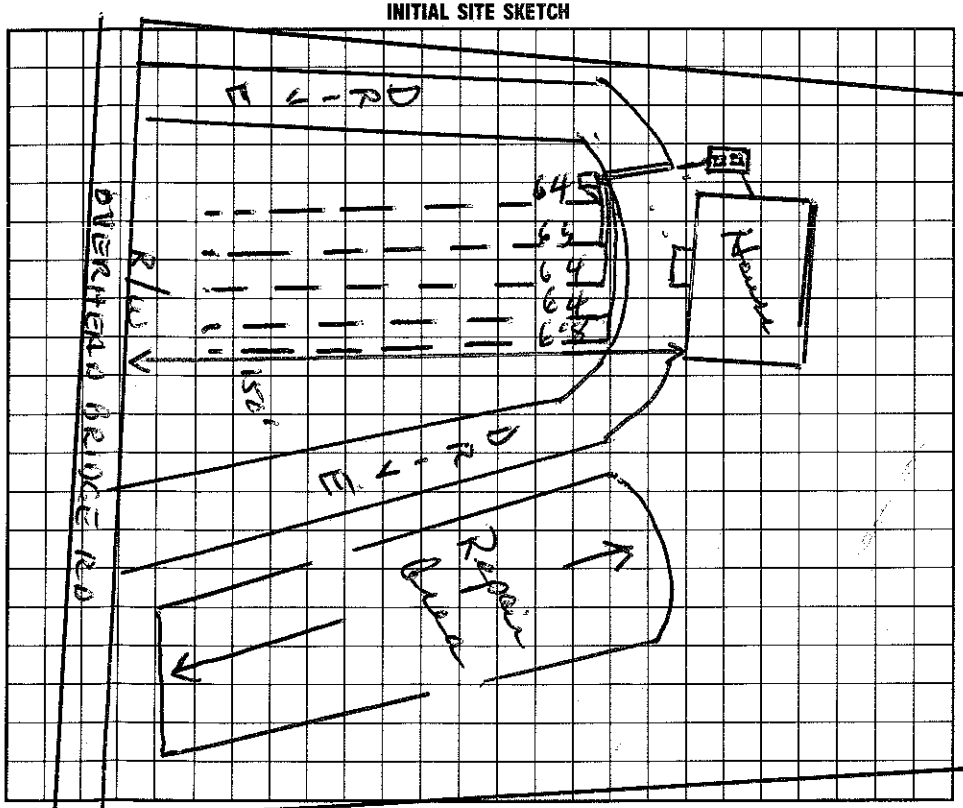

AS BUILT SKETCH

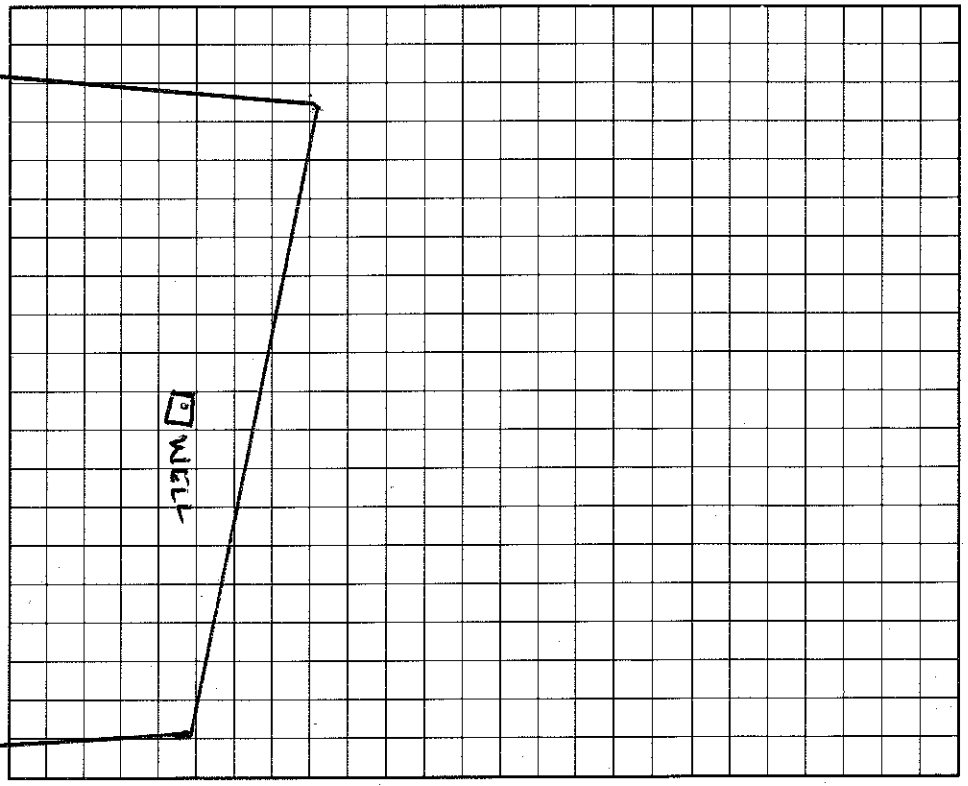

I understand that this permit can be suspended or revoked if any false information is supplied toward securing the permit/any unauthorized changes are made to the site/any unauthorized changes are made in the installation of the system.

Signed: X Mark C. Hester

Improvement Permit by: Wesley Sparkes date 11/30/95

Authorization to Construct: Wesley Sparkes date 11/30/95

Installed by: Curt Dunning

Certificate of Completion by: _____ date _____

Operation Permit by: C Brady Thomas EHSF date 4/8/96

HEALTH DEPT. COPY: WHITE INSPECTION COPY (FINAL): GREEN OWNER COPY (FINAL): YELLOW INSPECTION COPY (INITIAL): PINK OWNER COPY (INITIAL): GOLD