IREDELL COUNTY HEALTH DEPARTMENT — Authorization to Construct

STATESVILLE 704-878-5305 MOORESVILLE 704-664-5281

IMPROVEMENT PERMIT / ~~CERTIFICATE OF COMPLETION~~ / OPERATION PERMIT / EXISTING SYSTEM INSPECTION

PROPERTY DESCRIPTION NO. 3561 DATE 2/8/96 TAX MAP NO. 1N11A 28 4668 51 1609 Watershed: ☐ Yes ☒ No

OWNER OR CONTRACTOR Brightstar Development Co. PHONE: Business 664-0809 Home

ADDRESS 777 Oak Ridge Farm Rd. Mooresville, NC. 28115

LOCATION 150 East Pt. Overhead Bridge Rd. TR. Scotland Dr. (R) corner lot

SUBDIVISION Highland Crossing BLOCK / SECTION 1 LOT 28 LOT AREA 43,239 SITE CLASS. PS DESIGN FLOW 360 L.T.A.R. .3

Septic Tank: 1000 Gallons; STB 794 Date 1/24/96

Pump Tank: 1000 Gallons; PT 27 ~~24~~ 25 Date 11/11/95

Pump Make: ZOELLER Model N-98A Serial No. 11

Nitrification Field: No Fields 1 Square Feet 1200 Linear Feet 400

No Lines 3 Trench Width 36" Max Trench Bottom Depth 30" Gravel Depth 12"

☒ New System ☐ Repair System Type: ☐ I ☐ II ☒ III ☐ IV ☐ V ☐ VI

System Description: Pres Manifold - Conventional

Repair System Description: Pres I - INFILTRATOR

Maintenance Agreement Required: ☐ Yes ☒ No

☒ House/Mod. Home ☐ Mobile Home ☐ Business ☐ Other

No. Bedrooms 3 No. Bathrooms 2.5 No. Employees

☐ Slab ☒ Crawl Space ☐ Basement w/plumbing ☐ Basement wo/plumbing


Water Supply: ☒ Individual ☐ Community ☐ Public

Comments:


Comments:

INITIAL SITE SKETCH

1" = 60'

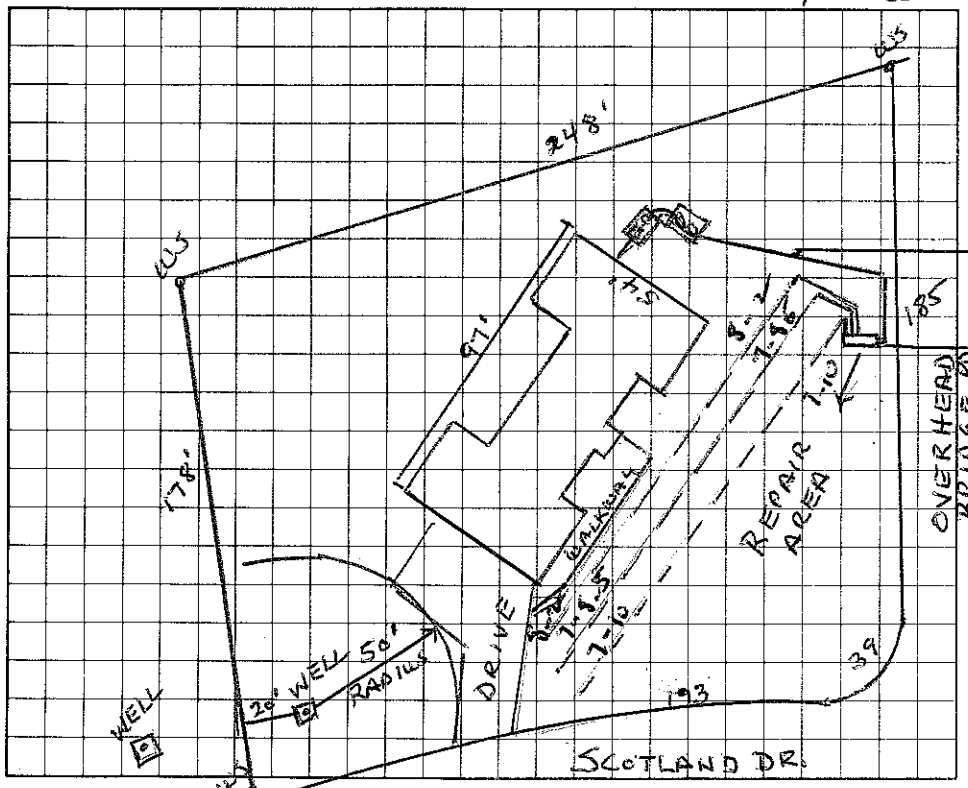

AS BUILT SKETCH

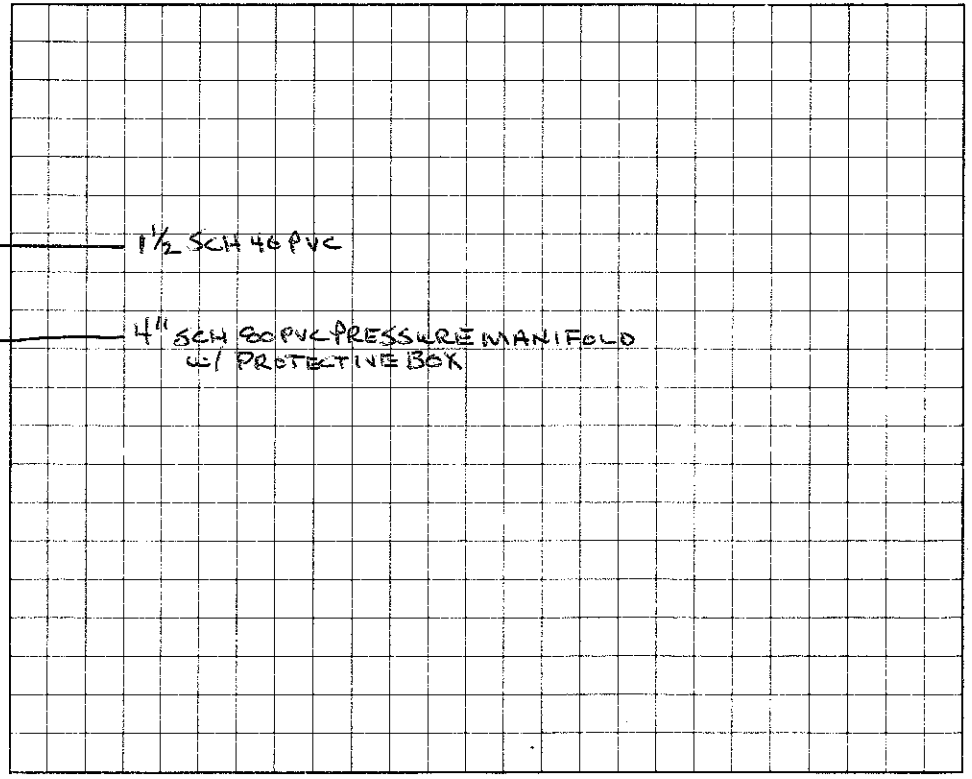

I understand that this permit can be suspended or revoked if any false information is supplied toward securing the permit/any unauthorized changes are made to the site/any unauthorized changes are made in the installation of the system.

Signed: X Susan K. Brown

Improvement Permit by: Wesley Sparks RS. date 2/8/96

~~Authorization~~ Existing System Inspection by: Wesley Sparks RS. date 2/8/96

Installed by: Julian Bowles

Certificate of Completion by: date

Operation Permit by: Wesley Sparks RS. date

HEALTH DEPT. COPY: WHITE INSPECTION COPY (FINAL): GREEN OWNER COPY (FINAL): YELLOW INSPECTION COPY (INITIAL): PINK OWNER COPY (INITIAL): GOLD