IREDELL COUNTY HEALTH DEPARTMENT

Authorization to Construct

STATESVILLE 704-878-5305 MOORESVILLE 704-664-5281

IMPROVEMENT PERMIT / ~~CERTIFICATE OF COMPLETION~~ / OPERATION PERMIT / EXISTING SYSTEM INSPECTION

PROPERTY DESCRIPTION NO. 4217 DATE 10/28/96 TAX MAP NO. 1N 11 A 22 Watershed: X Yes ☐ No

OWNER OR CONTRACTOR Brighton Development PHONE: ~~Business~~ 4068-51-8596 Home

ADDRESS 777 Oakridge Farm Rd. Mooresville NC. 28115

LOCATION Bigelow Dairy 150 E TL on Overhead Bridge TR. Scotland Acres TR Bigelow lot on (R) of

SUBDIVISION Highland Crossing BLOCK / SECTION LOT 22 LOT AREA .93 Ac SITE CLASS PS DESIGN FLOW 360 L.T.A.R. .3

Septic Tank: 1000 Gallons; STB 994 Date 10/3/96

Pump Tank: 1000 Gallons; PT Date

Pump Make: Model Serial No.

Nitrification Field: No Fields 1 Square Feet 1200 Linear Feet 400

No Lines 4 Trench Width 36" Max Trench Bottom Depth 24" Gravel Depth 12"

X New System ☐ Repair System Type: I, II, III, IV, V, VI

System Description: CRAW. CONVENTIONAL

Repair System Description: SAME

Maintenance Agreement Required: ☐ Yes X No

X House/Mod. Home No. Bedrooms 3

☐ Mobile Home No. Bathrooms 2.5

☐ Business No. Employees

☐ Other


☐ Slab X Crawl Space ☐ Basement w/plumbing ☐ Basement wo/plumbing

Water Supply: X Individual ☐ Community ☐ Public

Comments:

Comments:

INITIAL SITE SKETCH

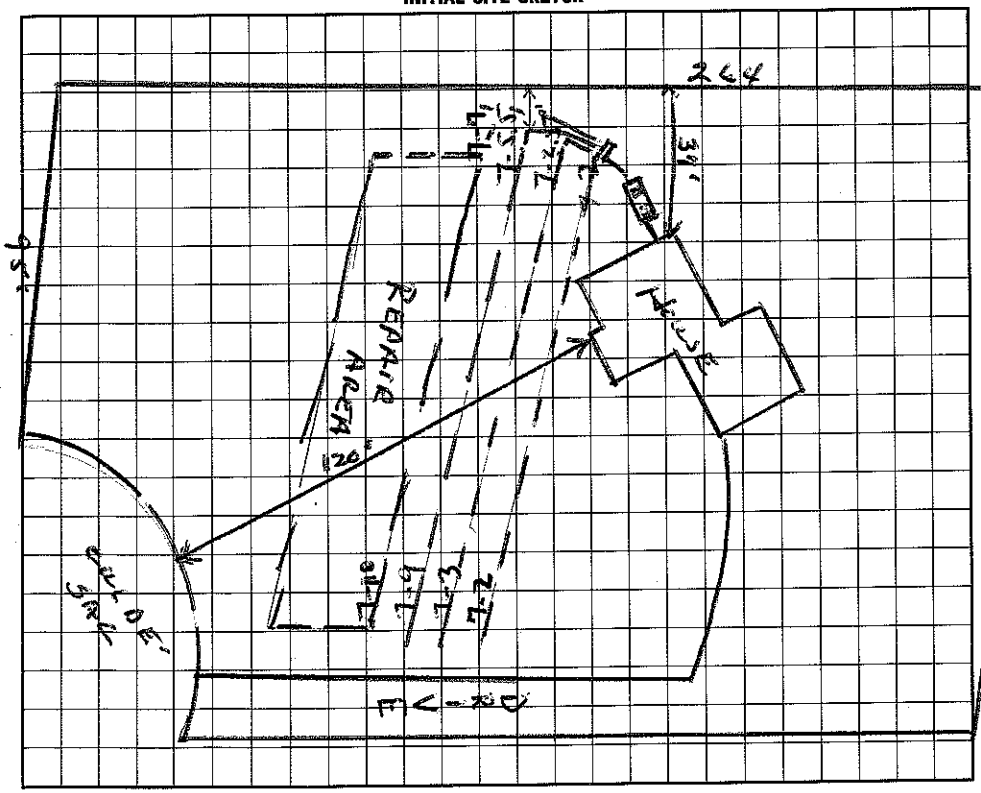

AS BUILT SKETCH

I understand that this permit can be suspended or revoked if any false information is supplied toward securing the permit/any unauthorized changes are made to the site/any unauthorized changes are made in the installation of the system.

Authorization to Construct valid for 12 months.

Signed: X

Improvement Permit by: Wesley Sparks R.S. date 10/28/96

Existing System Inspection by: Wesley Sparks R.S. date 10/29/96

Installed by: Julian Bowles

Certificate of Completion by: date

Operation Permit by: Wesley Sparks R.S. date 1/6/97

HEALTH DEPT. COPY: WHITE INSPECTION COPY (FINAL): GREEN OWNER COPY (FINAL): YELLOW INSPECTION COPY (INITIAL): PINK OWNER COPY (INITIAL): GOLD