IREDELL COUNTY HEALTH DEPARTMENT

Statesville Office (704) 878-5305 Mooresville Office (704) 660-3625 PERMIT # 213108

IMPROVEMENT PERMIT / AUTHORIZATION TO CONSTRUCT / OPERATION PERMIT / EXISTING SYSTEM

PIN # 4668-52-3797

APPLICANT: DAVE SPURY APPLICANT ADDRESS: 233 OVERHEAD BRIDGE RD. ; MOORESVILLE

SITE ADDRESS: SAME PHONE: 704-277-9057 ALT. PHONE:

SITE DIRECTIONS: 150 E, TL OVERHEAD BRIDGE, ON R


SUBDIVISION: J.D. Oliphant SECTION: — LOT # 6 LOT AREA: 4.35 AC DESIGN FLOW: 480 L.T.A.R.: .375

Septic Tank	EXISTING (gal)	STB		Date		☐ New System ☐ Repair ☑ Expansion	System Type: I II III IV V VI	☑ Residence	No. Bedrooms	4	Water Supply
Pump Tank	(gal)	PT		Date		System Description:	GRAVEL	☐ Business	No. Persons		☑ Private
Pump Make		Model		Serial #		Repair System Description:	SAME	☐ Other	No. Employees		☐ Public
# Nitrification Fields	1	# Lines	2@54'	Linear Ft:	108'	Maintenance Agreement Required:	☐ YES ☑ NO	☐ Slab	☑ Crawl Space		☐ Community
Trench Width	36"	Max. Trench Bottom Depth	36"	Gravel Depth	12"		☑ GRAVITY ☐ PRESSURE	☐ Basement w/plumbing		☐ Basement w/o plumbing	


Comments / Conditions:

* EXPANDING FROM 3 TO 4 BEDROOMS

INITIAL SITE SKETCH

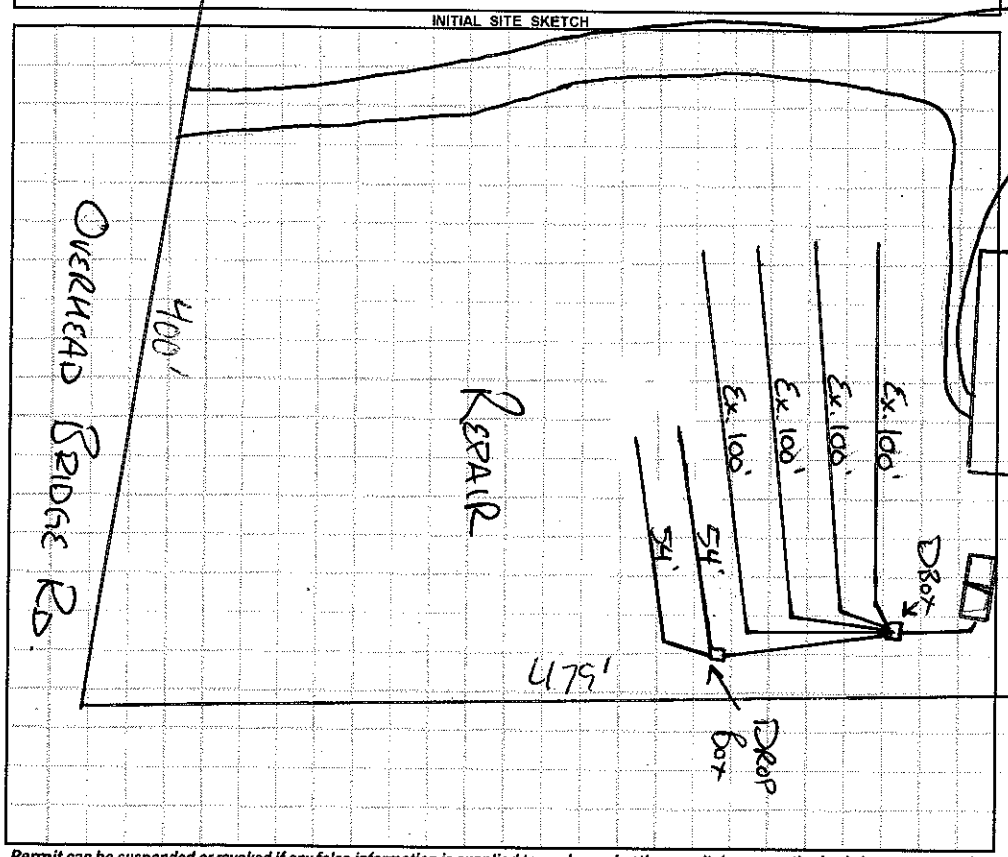

AS BUILT SKETCH

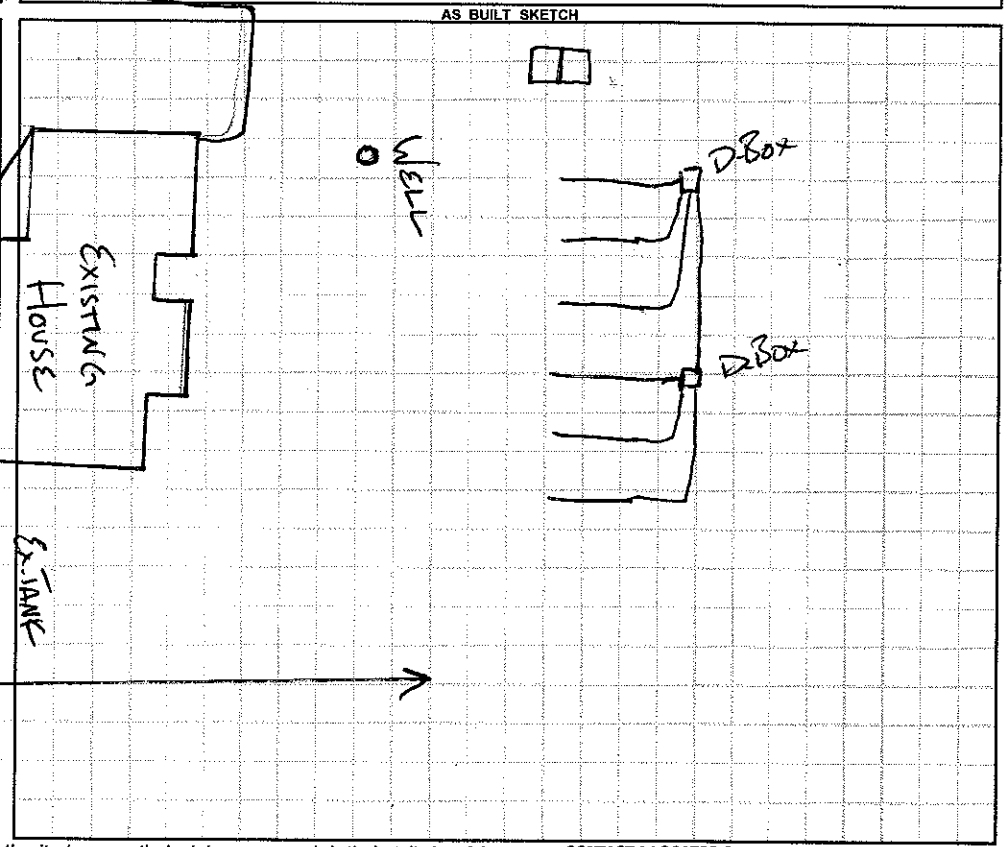

Permit can be suspended or revoked if any false information is supplied toward securing the permit / any unauthorized changes are made to the site / any unauthorized changes are made in the installation of the system. **CONTACT A LOCATOR SERVICE PRIOR TO ANY EXCAVATION**

☐ **IMPROVEMENT PERMIT** ***with plat*** *valid without expiration.* ☐ **IMPROVEMENT PERMIT** ***with site plan*** *valid for 60 mos.* ☑ **AUTHORIZATION TO CONSTRUCT** *valid for period equal to IMPROVEMENT PERMIT--not to exceed 60 mo.*

Owner / Applicant Signature: Dave Spury Date: 10-15-15 Installed by: OWNER

IMPROVEMENT PERMIT by: RA APPROVED Date: OCT 09 2015 OPERATION PERMIT by: RA Date: 1-12-16

AUTHORIZATION TO CONSTRUCT by: RA APPROVED Date: OCT 09 2015 Existing System Inspected by: Date:

Health Dept. Copy - WHITE Applicant (Final Approval) - YELLOW Applicant (Conditional Approval) - PINK