*THIS Permit VOIDS PREVIOUS PERMIT DATED 9/1/05 * 1:30

IREDELL COUNTY HEALTH DEPARTMENT

STATESVILLE 704-878-5305 MOORESVILLE 704-664-5281

IMPROVEMENT PERMIT / AUTHORIZATION TO CONSTRUCT / OPERATION PERMIT / EXISTING SYSTEM INSPECTION

PERMIT# ~~13077~~ 135230 PIN# 4668 52 3787 DATE 3/2/06

OWNER OR APPLICANT DAVE SPURY PHONE: Business 704 277 9057 Home

ADDRESS 1044 COOLE CREEK HWY MOORESVILLE, NC 28115

LOCATION 150 E ⓔ OVERHEAD BRIDGE Ⓡ LOT 233 OVERHEAD BRIDGE RD

SUBDIVISION NA BLOCK / SECTION LOT LOT AREA 4.35 ACRES SITE CLASS. PS DESIGN FLOW 360 GPD L.T.A.R. .3

Septic Tank: 1000 Gallons; STB 794 Date

Pump Tank: Gallons; PT Date

Pump Make: Model Serial No.

Nitrification Field: No Fields 1 Square Feet eq 1200 Linear Feet 400'

No Lines 3 Trench Width 36" Max Trench Bottom Depth 36" Gravel Depth 12"

☒ New System ☐ Repair ☐ Expansion System Type: I Ⓘ III IV V VI

System Description: CONVENTIONAL

Repair System Description: SAME

Maintenance Agreement Required: ☐ Yes ☒ No

☒ Gravity ☐ Pressure

☒ House/Mod. Home No. Bedrooms 3

☐ Mobile Home No. Persons

☐ Business No. Employees

☐ Other


Water Supply: ☒ Individual ☐ Public ☐ Community

☐ Slab ☐ Crawl Space ☐ Basement w/plumbing ☒ Basement wo/plumbing


Comments:/Conditions: INSTALL ON CONTOUR. MAINTAIN SETBACKS.
ACCEPTED SYSTEM MAY BE SUBSTITUTED.

Comments:/Conditions:

INITIAL SITE SKETCH

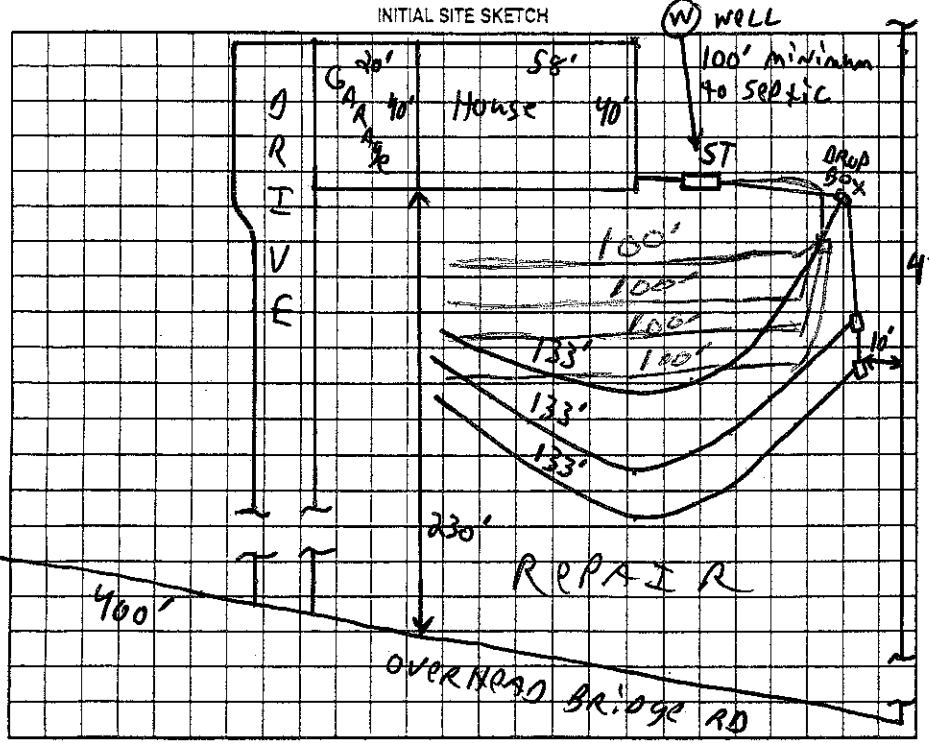

AS BUILT SKETCH

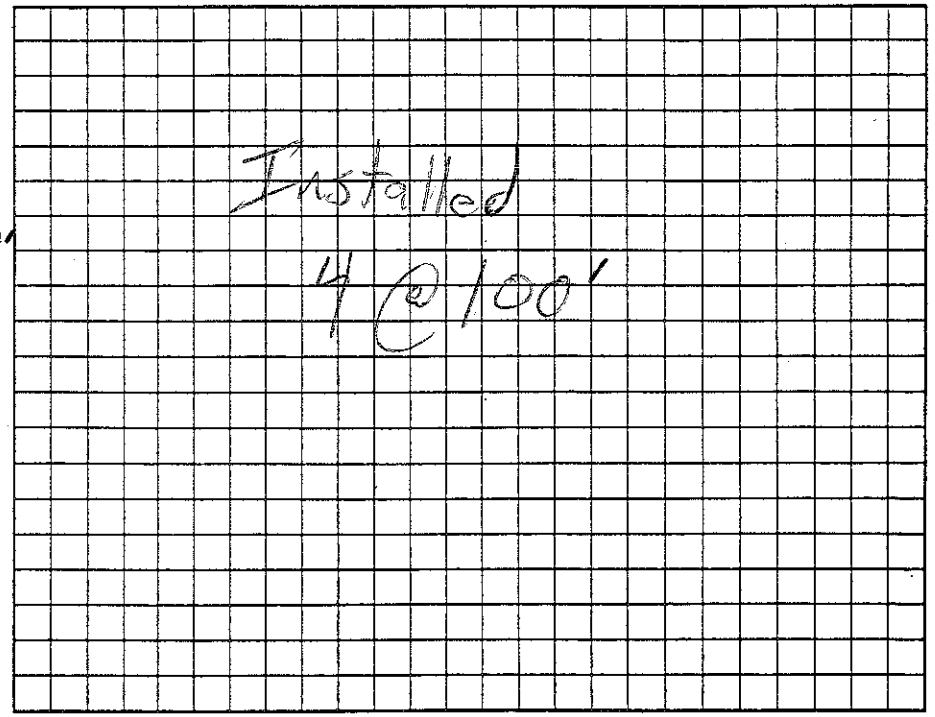

Permit can be suspended or revoked if any false information is supplied toward securing the permit/any unauthorized changes are made to the site/any unauthorized changes are made in the installation of the system. Improvement Permit with plat valid without expiration ☐ Improvement Permit with site plan valid for sixty months ☒ Authorization to Construct is valid for a period equal to that of Improvement Permit – not to exceed sixty months.

Signed: date 3/3/06

Improvement Permit by: date 3/2/06

Authorization to Construct by: date 3/3/06

Installed by: Garagard

Operation Permit by: RS date 8/21/06

Existing System Inspection by: date

HEALTH DEPT. COPY: WHITE OWNER COPY (FINAL): YELLOW OWNER COPY (INITIAL): PINK