IREDELL COUNTY HEALTH DEPARTMENT

Authorization to Construct

STATESVILLE 704-878-5305 MOORESVILLE 704-664-5281

IMPROVEMENT PERMIT / ~~CERTIFICATE OF COMPLETION~~ / OPERATION PERMIT / EXISTING SYSTEM INSPECTION

PROPERTY DESCRIPTION NO. 3560 DATE 2/2/96 TAX MAP NO. 1N11A3 Watershed: ☒ Yes ☐ No

OWNER OR CONTRACTOR Bright Star Development (TOM REILLY) PHONE: Business 664-0809 ~~Home~~ 4668-52-4142

ADDRESS 777 Oak Ridge Farm Rd. Mooresville, NC. 28115

LOCATION Overhead Bridge TR Highland Crossing TL Newcastle Court, L of cul-de-sac

SUBDIVISION Highland Crossing BLOCK / SECTION ____ LOT 3 LOT AREA ~ .92 AC SITE CLASS PS DESIGN FLOW 360 L.T.A.R. .3

Septic Tank: 1000 Gallons; STB 704 Date 3/5/96

Pump Tank: 1000 Gallons; PT ____ Date ____

Pump Make: ____ Model ____ Serial No. ____

Nitrification Field: No Fields 1 Square Feet 1200 Linear Feet ~~X~~ 400

No Lines 3 Trench Width 36" Max Trench Bottom Depth 32" Gravel Depth 12"

☒ New System ☐ Repair System Type: I (II) III IV V VI

System Description: GRAV - CONVENTIONAL

Repair System Description: GRAV - INFILTRATOR

Maintenance Agreement Required: ☐ Yes ☐ No

☒ House/Mod. Home ☐ Mobile Home ☐ Business ☐ Other

No. Bedrooms 3 No. Bathrooms 2.5 No. Employees ____


☐ Slab ☒ Crawl Space ☐ Basement w/plumbing ☐ Basement wo/plumbing

Water Supply: ☒ Individual ☐ Community ☐ Public

Comments: ~~X~~ Gravity Conventional Drainfield

Comments: BLDG. PERMIT # 59317

INITIAL SITE SKETCH

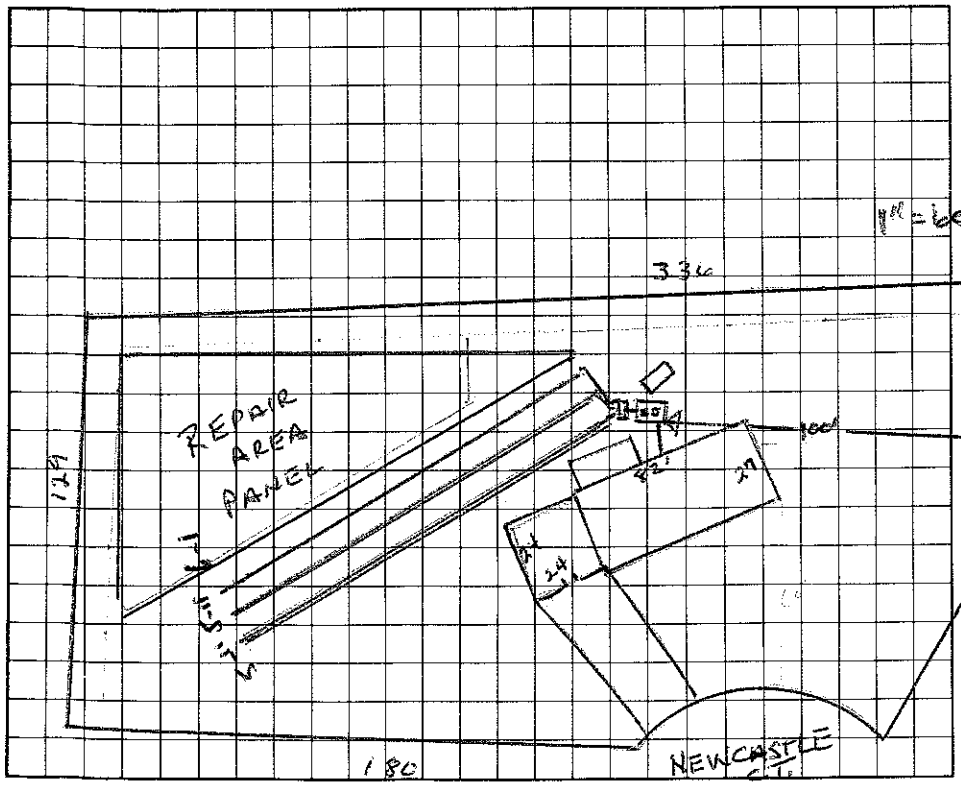

AS BUILT SKETCH

I understand that this permit can be suspended or revoked if any false information is supplied toward securing the permit/any unauthorized changes are made to the site/any unauthorized changes are made in the installation of the system.

Signed: Susan K. Brown

Improvement Permit by: Wesley Sparks RS date 2/8/96

~~Existing System Inspection by:~~ Certificate of Completion by: ____ date ____

Operation Permit by: Wesley Sparks RS date 7/12/96

Installed by: Julian Bowles

HEALTH DEPT. COPY: WHITE INSPECTION COPY (FINAL): GREEN OWNER COPY (FINAL): YELLOW INSPECTION COPY (INITIAL): PINK OWNER COPY (INITIAL): GOLD