IREDELL COUNTY HEALTH DEPARTMENT

STATESVILLE 704-878-5305 MOORESVILLE 704-664-5281

IMPROVEMENT PERMIT / CERTIFICATE OF COMPLETION / OPERATION PERMIT / EXISTING SYSTEM INSPECTION

PROPERTY DESCRIPTION NO. 2647 DATE 7/25/94 TAX MAP NO. IN 11A5 Watershed: ☐ Yes ☐ No

OWNER OR CONTRACTOR Brightstar Develop. ~~PHONE: Business~~ 464-8-52-6099 Home

ADDRESS 2+7 Box 712 Mgsd.

LOCATION 150 E TL Overhead Bridge TR, 1st (L) to Rosthenson (R)

SUBDIVISION Highland Crossing BLOCK / SECTION LOT 5 LOT AREA ~2.91AC SITE CLASS. P DESIGN FLOW 440 L.T.A.R. .3

Septic Tank: 1000 Gallons; STB 794 Date 6/23/94

Pump Tank: Gallons; PT Date

Pump Make: Model Serial No.

Nitrification Field: No Fields 1 Square Feet 1680 Linear Feet 510

No Lines 4 Trench Width 36" Max Trench Bottom Depth 28" Gravel Depth 12"

☑ New System ☐ Repair System Type: I, (II), III, IV, V, VI

System Description: CONV. - DIST BOX

Repair System Description:

Maintenance Agreement Required: ☐ Yes ☐ No

☑ House/Mod. Home No. Bedrooms 4

☐ Mobile Home No. Bathrooms 3

☐ Business No. Employees

☐ Other

☐ Slab ☐ Crawl Space ☐ Basement w/plumbing ☐ Basement wo/plumbing


Water Supply:
☑ Individual
☐ Community
☐ Public
NOT DRILLED

Comments:

INITIAL SITE SKETCH

Comments:

AS BUILT SKETCH

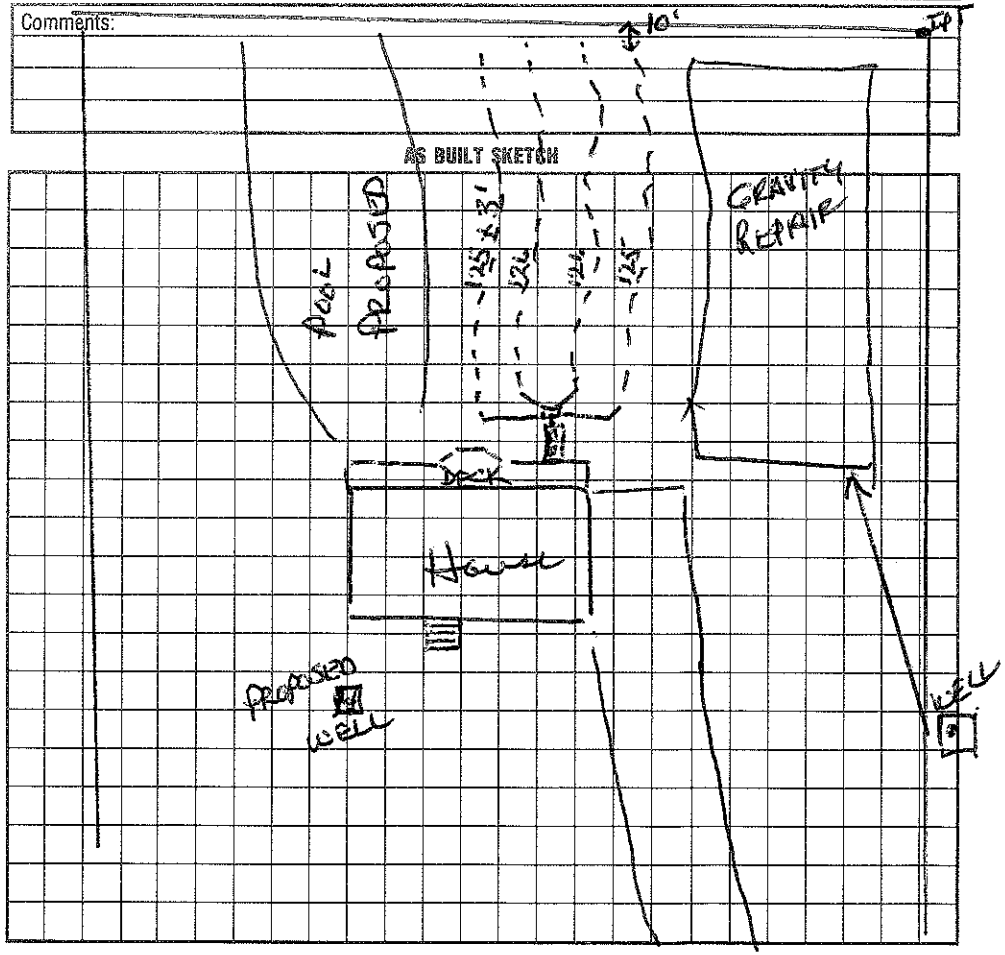

I understand that this permit can be suspended or revoked if any false information is supplied toward securing the permit/any unauthorized changes are made to the site/any unauthorized changes are made in the installation of the system. Improvement Permit is valid for 60 months from date of issuance.

Signed:

Improvement Permit by: date

Existing System Inspection by: date

Installed by: Tucker Septic Tank

Certificate of Completion by: Wesley Sparks RS. date 7/25/94

Operation Permit by: date

HEALTH DEPT. COPY: WHITE INSPECTION COPY (FINAL): GREEN OWNER COPY (FINAL): YELLOW INSPECTION COPY (INITIAL): PINK OWNER COPY (INITIAL): GOLD