1:30

# IREDELL COUNTY HEALTH DEPARTMENT

STATESVILLE 704-878-5305 MOORESVILLE 704-664-5281

## IMPROVEMENT PERMIT / AUTHORIZATION TO CONSTRUCT / OPERATION PERMIT / EXISTING SYSTEM INSPECTION

PERMIT# 139202 PIN# 4668 53 7037.120 4668-53-5059 DATE 11/27/06

OWNER OR APPLICANT Larry + Diana BEAM + LINA COMPTON PHONE: Business 704-664-2090 Home

ADDRESS 2740 SLOOP RD. MT. ULLA, NC 28125

LOCATION 120 OLIPHANT RD. MOORESVILLE, NC. 28115

SUBDIVISION BLOCK / SECTION LOT 1 LOT AREA ~1.12AC SITE CLASS. PS DESIGN FLOW 480 L.T.A.R. .3

Septic Tank: 1000 Gallons; STB 794 Date 9-26-07
Pump Tank: Gallons; PT Date
Pump Make: Model Serial No.
Nitrification Field: No Fields 1 Square Feet 1200 Linear Feet 400
No Lines 4@100' Trench Width 3 Max Trench Bottom Depth 3'

[X] New System ☐ Repair ☐ Expansion System Type: I II [III] IV V VI
System Description: GRAVITY-25% REDUCTION
Repair System Description: SAME TYPE
Maintenance Agreement Required: ☐ Yes [X] No

[X] House/Mod. Home ☐ Mobile Home ☐ Business ☐ Other
No. Bedrooms 4 No. Persons 8 No. Employees

Water Supply: [X] Individual ☐ Public ☐ Community


Gravel Depth No [X] Gravity ☐ Pressure ☐ Slab [X] Crawl Space ☐ Basement w/plumbing ☐ Basement wo/plumbing

Comments:/Conditions:


1" = 50'

INTERCEPT DITCH

INITIAL SITE SKETCH

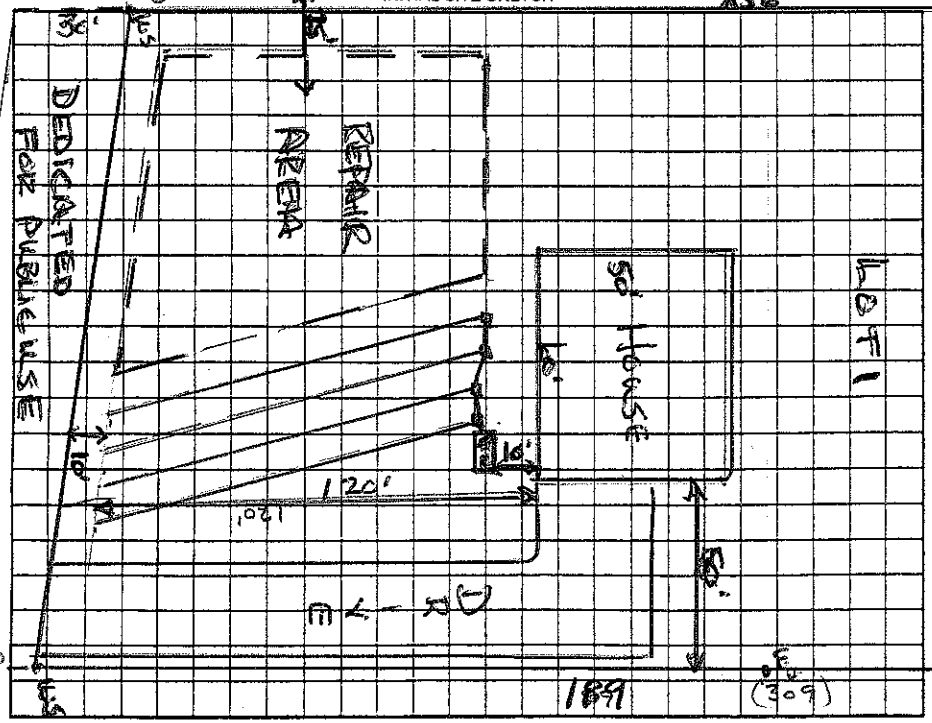


AS BUILT SKETCH

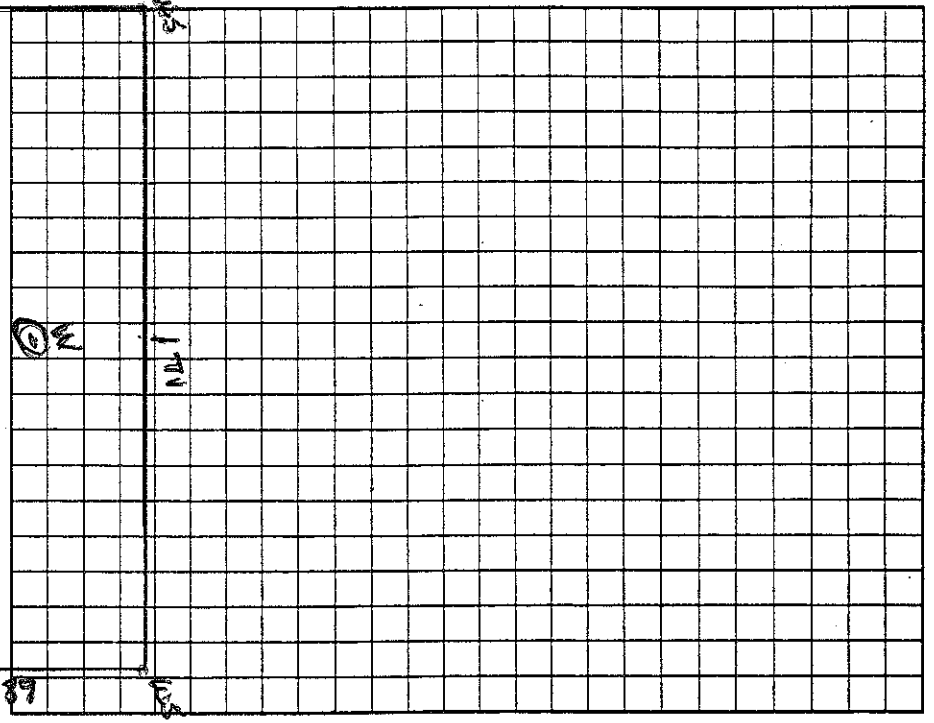


OLIPHANT RD

130

Permit can be suspended or revoked if any false information is supplied toward securing the permit/any unauthorized changes are made to the site/any unauthorized changes are made in the installation of the system. Improvement Permit with plat valid without expiration ☐ Improvement Permit with site plan valid for sixty months ☐ Authorization to Construct is valid for a period equal to that of Improvement Permit – not to exceed sixty months.

Signed: Larry E Beam date 12-1-06 Installed by: Beam

Improvement Permit by: Wesley Sparks R.S. date 11/27/06 Operation Permit by: date 5-15-08

Authorization to Construct by: Wesley Sparks RS date 11/27/06 Existing System Inspection by: date

HEALTH DEPT. COPY: WHITE OWNER COPY (FINAL): YELLOW OWNER COPY (INITIAL): PINK