IREDELL COUNTY HEALTH DEPARTMENT

STATESVILLE 704-878-5305 MOORESVILLE 704-664-5281

IMPROVEMENT PERMIT / AUTHORIZATION TO CONSTRUCT / OPERATION PERMIT / EXISTING SYSTEM INSPECTION

PERMIT# 139205 PIN# 4668 53 7037 4668 85 39025 DATE 12/1/06

OWNER OR APPLICANT Larry Beam PHONE: Business 704-634-5246 Home

ADDRESS 2740 Sloop Rd. Mt. Ulla, NC 28125

LOCATION 150 E TL Overhead Bridge Rd. TR Old Ranch Rd to 3rd lot on (R)

SUBDIVISION BLOCK / SECTION LOT 3 LOT AREA ~1.2 Ac SITE CLASS. PS DESIGN FLOW 480 L.T.A.R. .3

Septic Tank: ~~1000~~ 1520 Gallons; STB 339 Date 2/14/07

Pump Tank: Gallons; PT Date

Pump Make: Model Serial No.

Nitrification Field: No Fields 1 Square Feet 1200 Linear Feet 401

No Lines ~~4 @ 100~~ Trench Width 3' Max Trench Bottom Depth 32" Gravel Depth No

☒ New System ☐ Repair ☐ Expansion System Type: I II (III) IV V VI

System Description: GRAV - 25% Reduced

Repair System Description: SAME

Maintenance Agreement Required: ☐ Yes ☒ No

☒ House/Mod. Home No. Bedrooms 4

☐ Mobile Home No. Persons

☐ Business No. Employees

☐ Other


Water Supply: ☐ Individual ☒ Public ☐ Community

☐ Gravity ☐ Pressure ☐ Slab ☐ Crawl Space ☐ Basement w/plumbing ☐ Basement wo/plumbing


Comments:/Conditions: 222

Comments:/Conditions: w/Infiltrator installed;

INITIAL SITE SKETCH

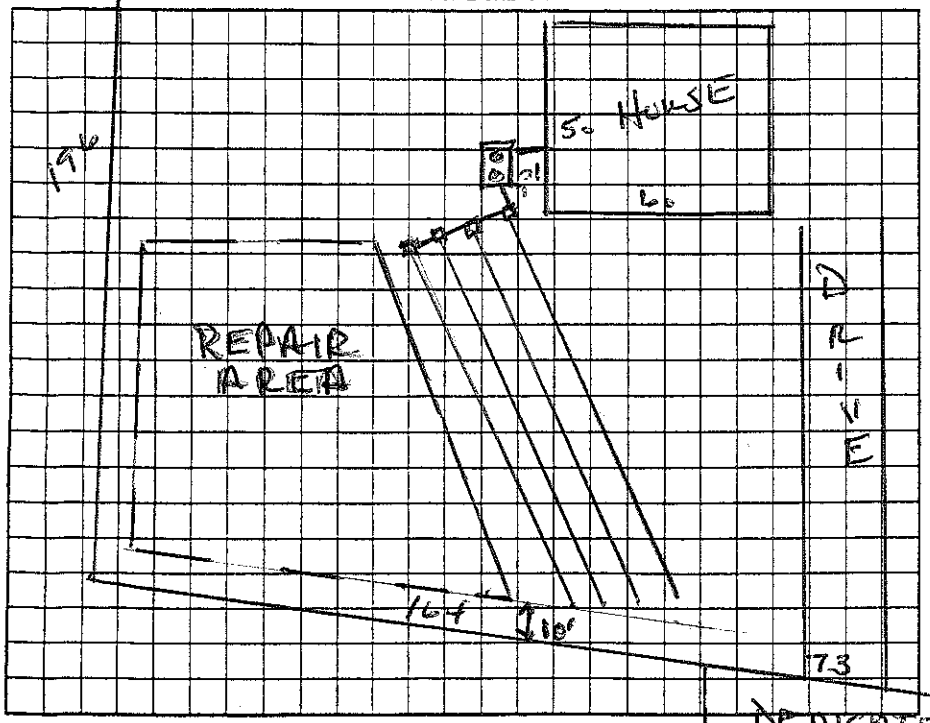

AS BUILT SKETCH

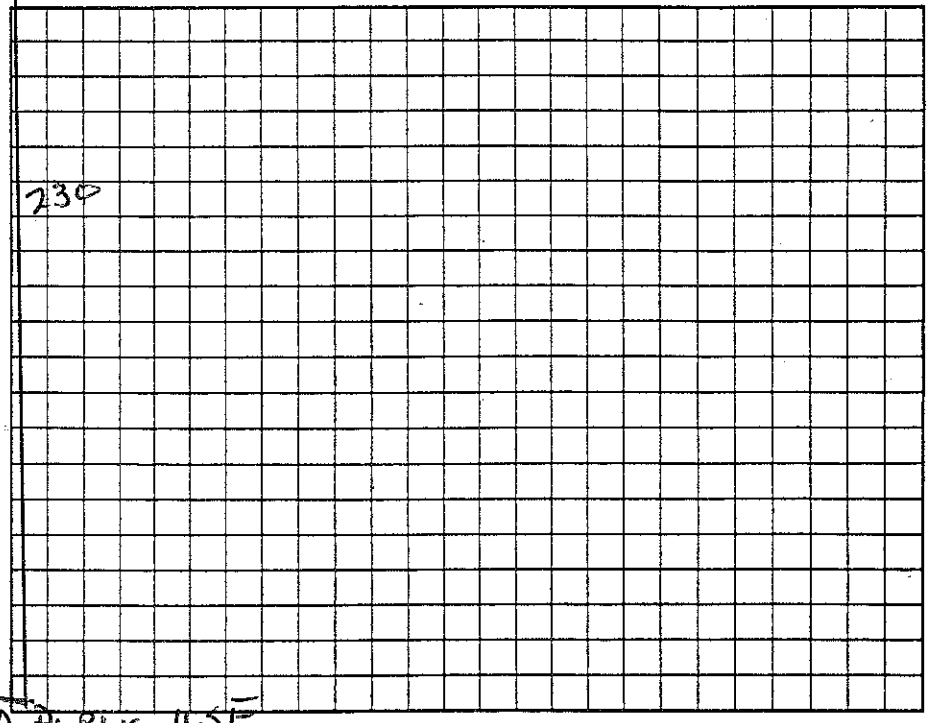

Permit can be suspended or revoked if any false information is supplied toward securing the permit/any unauthorized changes are made to the site/any unauthorized changes are made in the installation of the system. Improvement Permit with plat valid without expiration ☐ Improvement Permit with site plan valid for sixty months ☐ Authorization to Construct is valid for a period equal to that of Improvement Permit – not to exceed sixty months.

Signed: X Larry E Beam date 12/1/06 Installed by: Larry Beam

Improvement Permit by: Wesley Sparks R.S. date 12/1/06 Operation Permit by: Wesley Sparks R.S. date 4/5/07

Authorization to Construct by: Wesley Sparks RS date 12/1/06 Existing System Inspection by: date

HEALTH DEPT. COPY: WHITE OWNER COPY (FINAL): YELLOW OWNER COPY (INITIAL): PINK