4668560971

IREDELL COUNTY HEALTH DEPARTMENT

STATESVILLE 704-878-5305 MOORESVILLE 704-664-5281

IMPROVEMENT PERMIT / CERTIFICATE OF COMPLETION / OPERATION PERMIT / EXISTING SYSTEM INSPECTION

PROPERTY DESCRIPTION NO. REPAIR DATE 5/10/94 TAX MAP NO. REPAIR Watershed: ☑ Yes ☐ No

OWNER OR CONTRACTOR Charles Randolph PHONE: Business Home 663-2434

ADDRESS Mazeppa Rd. from 115-21N, 1st house on (L) past Overhead Bridge Rd.

LOCATION Mazeppa Rd

SUBDIVISION N/A BLOCK / SECTION N/A LOT N/A LOT AREA ACREAGE SITE CLASS. F DESIGN FLOW 240 L.T.A.R. .25

Septic Tank: EXISTING Gallons; STB Date

Pump Tank: Gallons; PT Date

Pump Make: Model Serial No.

Nitrification Field: No Fields 1 Square Feet 780 Linear Feet 260'

No Lines 2 Trench Width 3' Max Trench Bottom Depth 36-38" Gravel Depth

☐ New System ☑ Repair System Type: I (II) III, IV, V, VI

System Description: CONV - DIST. BOX

Repair System Description:

Maintenance Agreement Required: ☐ Yes ☑ No

☑ House/Mod. Home No. Bedrooms 2

☐ Mobile Home No. Bathrooms 2

☐ Business No. Employees

☐ Other


☐ Slab ☑ Crawl Space ☐ Basement w/plumbing ☐ Basement wo/plumbing

Water Supply: ☑ Individual ☐ Community ☐ Public


Comments:
TRYING TO KEEP LINES UP ON SLOPE AREA AND OUT OF LOW (CONCAVE) AREA OF OLD PIT.

Comments:

INITIAL SITE SKETCH

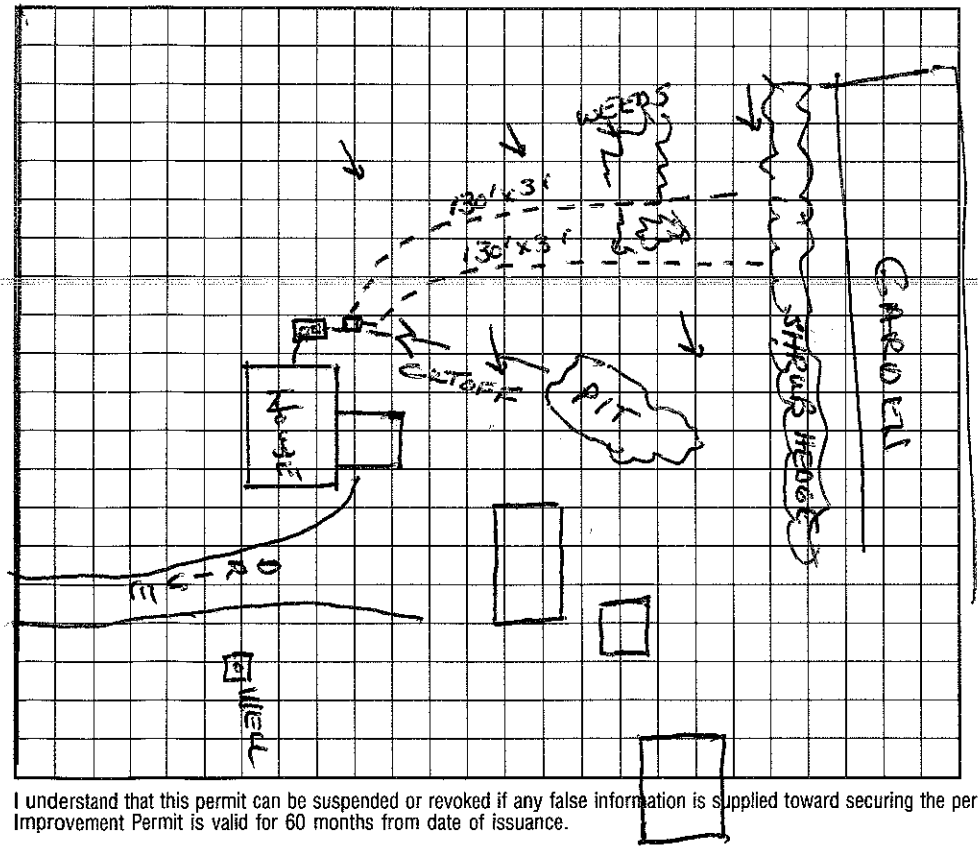

AS BUILT SKETCH

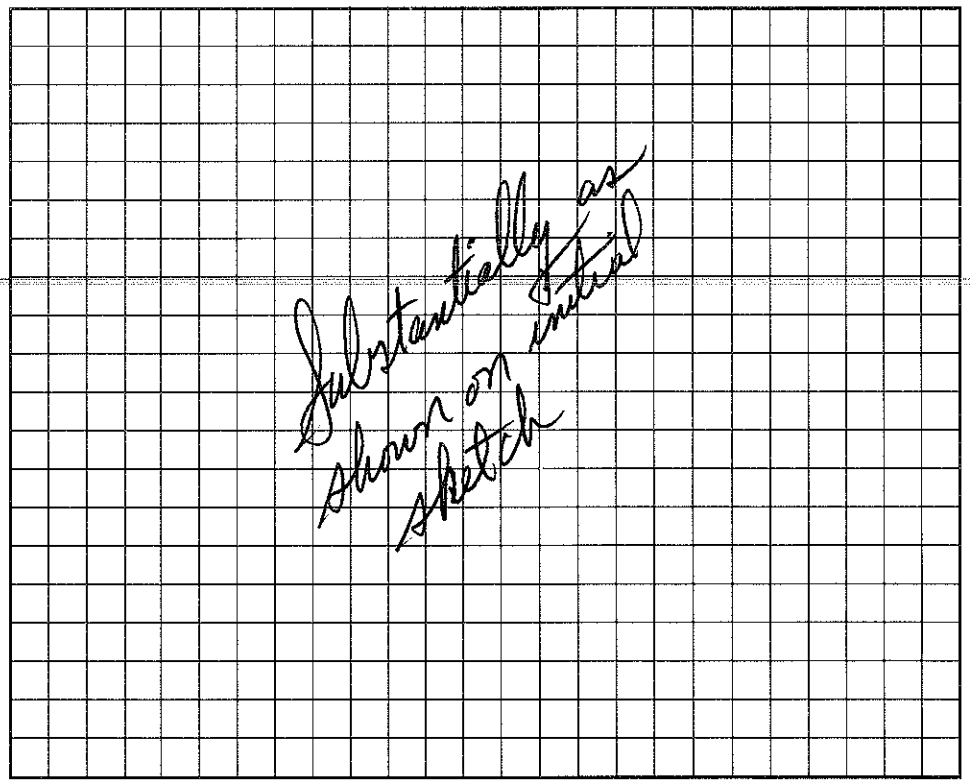

I understand that this permit can be suspended or revoked if any false information is supplied toward securing the permit/any unauthorized changes are made to the site/any unauthorized changes are made in the installation of the system. Improvement Permit is valid for 60 months from date of issuance.

Signed:

Improvement Permit by: Wesley Sparks R.S. date 5/10/94

Existing System Inspection by: date

Installed by: Tony Hammonds

Certificate of Completion by: Jerry R. Hinson IRS date 5/12/94

Operation Permit by: date

HEALTH DEPT. COPY: WHITE INSPECTION COPY (FINAL): GREEN OWNER COPY (FINAL): YELLOW INSPECTION COPY (INITIAL): PINK OWNER COPY (INITIAL): GOLD