New ST & Drainfield

# IREDELL COUNTY HEALTH DEPARTMENT

STATESVILLE 704-878-5305 MOORESVILLE 704-664-5281

## IMPROVEMENT PERMIT / AUTHORIZATION TO CONSTRUCT / OPERATION PERMIT / EXISTING SYSTEM INSPECTION

PERMIT# 089478 PIN# 4668571497 4 DATE 5/30/2000

OWNER OR CONTRACTOR M & L Ventures PHONE: Business _____ Home 663-3161

ADDRESS P.O. Box 1602 Mooresville, NC 28115

LOCATION Hwy 115 N TR Mazeppa Rd TL Hayes Ervin Rd (by Water Tower) ON LEFT

SUBDIVISION _____ BLOCK / SECTION _____ LOT _____ LOT AREA .63 Acre SITE CLASS. PS DESIGN FLOW 240gpd L.T.A.R. 6 RS

Septic Tank: 1000 Gallons; STB 794 Date 2/23/00

Pump Tank: _____ Gallons; PT _____ Date _____

Pump Make: _____ Model 594 Serial No. 198

Nitrification Field: No Fields 2 Square Feet ~~480~~ Linear Feet ~~360~~

No Lines ~~3~~ 4 Trench Width 36" Max Trench Bottom Depth 30"

☑ New System ☐ Repair System Type: I, II, III, IV, V, VI

System Description: EXISTING Gravity Convertional

Repair System Description: _____

Maintenance Agreement Required: ☐ Yes ☐ No

☐ House/Mod. Home ☒ Mobile Home ☐ Business ☐ Other

No. Bedrooms 2 No. Bathrooms 1 No. Employees _____


Water Supply: ☒ Individual ☐ Public ☐ Community Shar

☐ Slab ☐ Crawl Space ☐ Basement w/plumbing ☐ Basement wo/plumbing

Comments:/Conditions: Abandoned existing Septic Tank (Pump out & crush in & backfill) cut off any part of Drainfield less than 5' from PL Tie into remainder of Drainfield & Set New D-box.


Comments:/Conditions: Install additional Drainfield Bed 9'X45' or 2-45'X3' trenches 9' on center. Driveway must not extend over New Drainfield

INITIAL SITE SKETCH

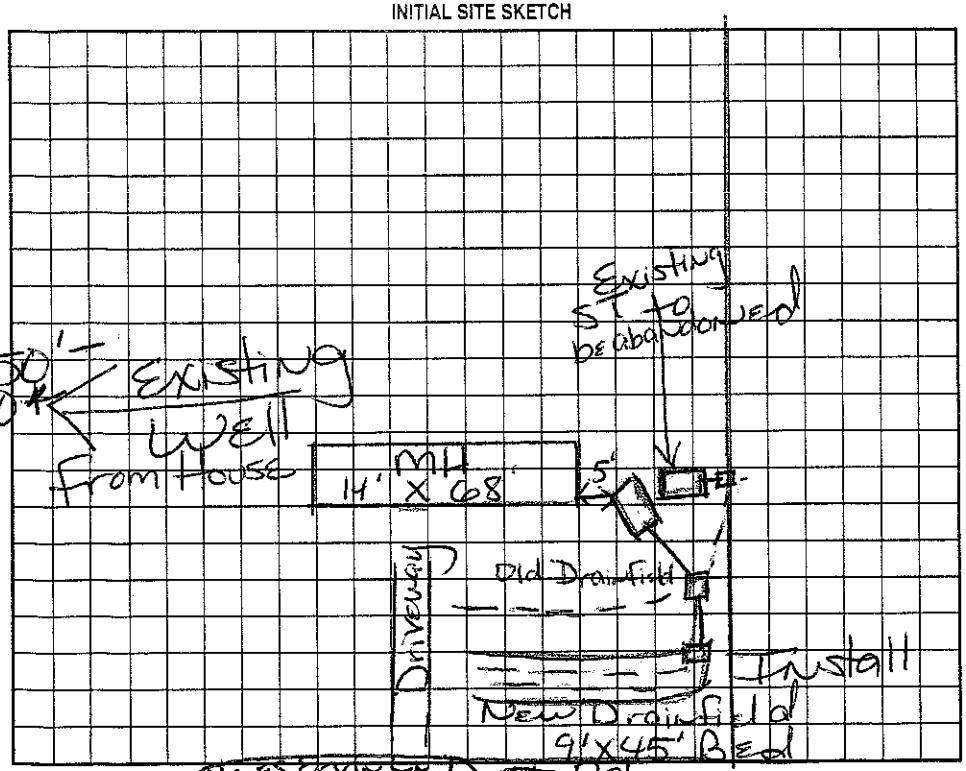


AS BUILT SKETCH

4/12/00 - Install 4@ 60'X3' Conventional Trenches. Use 50' setback from well - Page soil not Applicable. ACS.

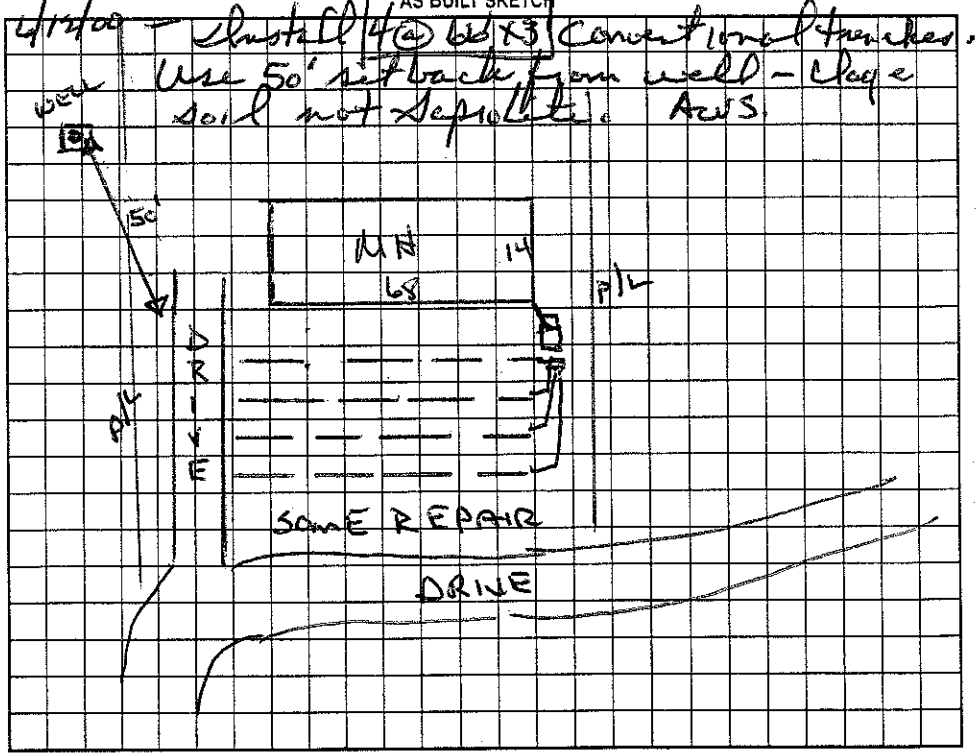


Permit can be suspended or revoked if any false information is supplied toward securing the permit/any unauthorized changes are made to the site/any unauthorized changes are made in the installation of the system. Improvement Permit with plat valid without expiration. Improvement Permit with site plan valid for sixty months. Authorization to Construct is valid for a period equal to that of Improvement Permit – not to exceed sixty months.

Signed _____ date _____ Installed by: Larry Beam

Improvement Permit by: Marina H. Dotson RS date 5/30/2000 Operation Permit by: Wesley Sparks RS. date 6/12/00

Authorization to Construct by: Marina H. Dotson date 5/30/2000 Existing System Inspection by: _____ date _____

HEALTH DEPT. COPY: WHITE OWNER COPY (FINAL): YELLOW OWNER COPY (INITIAL): PINK