IREDELL COUNTY HEALTH DEPARTMENT

STATESVILLE 704-878-5305 MOORESVILLE 704-664-5281

IMPROVEMENT PERMIT / AUTHORIZATION TO CONSTRUCT / OPERATION PERMIT / EXISTING SYSTEM INSPECTION

PERMIT# 128990/128993 PIN# 4668 57 7718 DATE 8/2/05

OWNER OR CONTRACTOR Alford Shepherd PHONE: Business 704 607 3250 Home

ADDRESS 4494 Long Cove Pt. Denver NC 28037

LOCATION 115 N, TR Mazeppa, on Lt beside Hayes-Irvin Rd

SUBDIVISION BLOCK / SECTION LOT LOT AREA 0.94ac SITE CLASS. PS DESIGN FLOW 480 L.T.A.R. 0.35

Septic Tank: ~~1000~~ 1500 Gallons; STB ~~750~~ 1014 Date 11/2/05

Pump Tank: Gallons; PT Date

Pump Make: Model Serial No.

Nitrification Field: No Fields 1 Square Feet 1035 Linear Feet 345

No Lines 3@115' Trench Width 36" Max Trench Bottom Depth 36" Gravel Depth —

☒ New System ☐ Repair System Type: I, II, III, IV, V, VI

System Description: Gravity 25% Reduct.

Repair System Description: Pump 25% Reduct.

Maintenance Agreement Required: ☐ Yes ☒ No

☐ House/Mod. Home No. Bedrooms 4

☐ Mobile Home No. Bathrooms

☐ Business No. Employees

☒ Other Duplex

☐ Slab ☒ Crawl Space ☐ Basement w/plumbing ☐ Basement wo/plumbing

Water Supply: ☒ Individual ☐ Public ☐ Community


Comments:/Conditions:

1" = 50'


Comments:/Conditions:

Quick 4 Installed

INITIAL SITE SKETCH

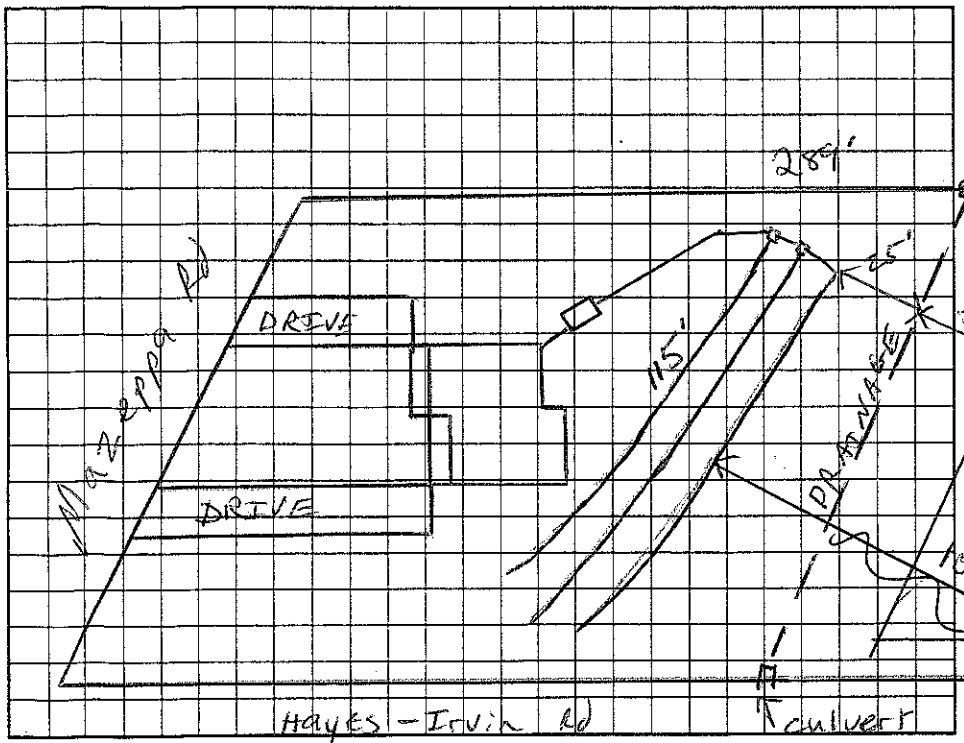

AS BUILT SKETCH

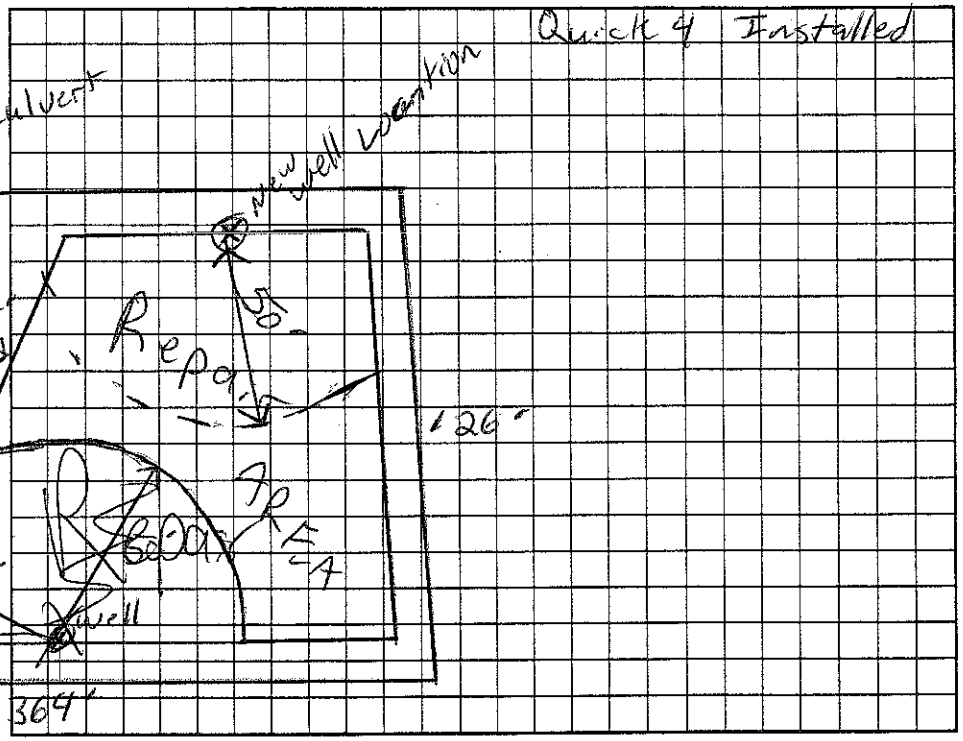

Permit can be suspended or revoked if any false information is supplied toward securing the permit/any unauthorized changes are made to the site/any unauthorized changes are made in the installation of the system. Improvement Permit with plat valid without expiration. Improvement Permit with site plan valid for sixty months. Authorization to Construct is valid for a period equal to that of Improvement Permit – not to exceed sixty months.

Signed: date 8-5-05 Installed by: Joe Thompson

Improvement Permit by: RS date 8/2/05 Operation Permit by: RS date 2/16/06

Authorization to Construct by: RS date 8/2/05 Existing System Inspection by date

HEALTH DEPT. COPY: WHITE OWNER COPY (FINAL): YELLOW OWNER COPY (INITIAL): PINK