4668585316

IREDELL COUNTY HEALTH DEPARTMENT

STATESVILLE 704-878-5305 MOORESVILLE 704-664-5281

IMPROVEMENT PERMIT / CERTIFICATE OF COMPLETION / OPERATION PERMIT / EXISTING SYSTEM INSPECTION

PROPERTY DESCRIPTION NO. 2331 DATE 4/15/96 TAX MAP NO. 4C-C-15 Watershed: ☑ Yes ☐ No

OWNER OR CONTRACTOR Dale Nichols PHONE: Business Home 664-5155

ADDRESS Mooresville NC 28115

LOCATION 21-115 N - TR Mezepper Rd - TL Nichols Ln. - at end of Nichols Ln.

SUBDIVISION BLOCK / SECTION LOT LOT AREA SITE CLASS. IS DESIGN FLOW 360gpd L.T.A.R. .3 gpm/ft

Septic Tank: 1000 Gallons; STB Date

Pump Tank: Gallons; PT Date

Pump Make: Model Serial No.

Nitrification Field: No Fields 1 Square Feet Linear Feet

No Lines Trench Width Max Trench Bottom Depth Gravel Depth

☑ New System ☐ Repair System Type: I II III IV V VI

System Description: Gravity Conventional

Repair System Description:

Maintenance Agreement Required: ☐ Yes ☐ No

☐ House/Mod. Home No. Bedrooms 3

☑ Mobile Home No. Bathrooms 2

☐ Business No. Employees

☐ Other

☐ Slab ☑ Crawl Space ☐ Basement w/plumbing ☐ Basement wo/plumbing


Water Supply:
☑ Individual
☐ Community
☐ Public

Comments: Everything existing

Comments:

INITIAL SITE SKETCH

AS BUILT SKETCH

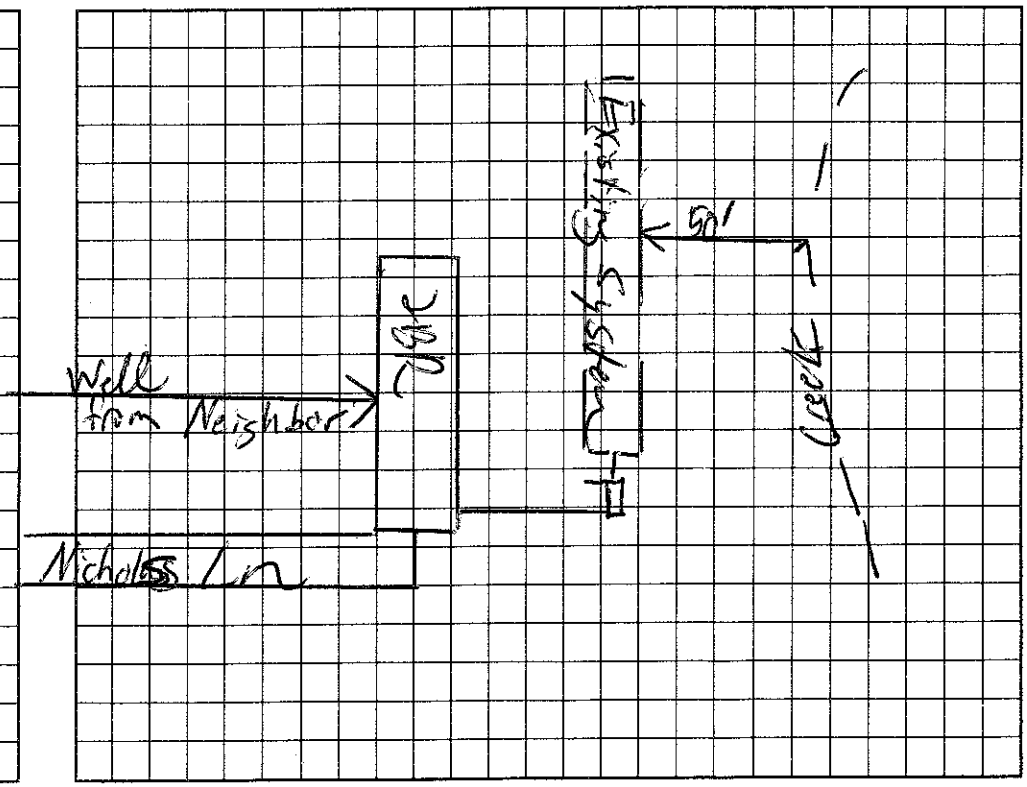

I understand that this permit can be suspended or revoked if any false information is supplied toward securing the permit/any unauthorized changes are made to the site/any unauthorized changes are made in the installation of the system.

Signed: Installed by:

Improvement Permit by: date Certificate of Completion by: date

Existing System Inspection by: C. Bud Graham EHST date 4/15/96 Operation Permit by: C. Bud Graham EHST date 4/15/96

HEALTH DEPT. COPY: WHITE INSPECTION COPY (FINAL): GREEN OWNER COPY (FINAL): YELLOW INSPECTION COPY (INITIAL): PINK OWNER COPY (INITIAL): GOLD