3100

IREDELL COUNTY HEALTH DEPARTMENT

STATESVILLE 704-878-5305 MOORESVILLE 704-664-5281

IMPROVEMENT PERMIT / AUTHORIZATION TO CONSTRUCT / OPERATION PERMIT / EXISTING SYSTEM INSPECTION

PERMIT# PIN# 4668594992 DATE 12-6-07

OWNER OR APPLICANT James Honeycutt PHONE: Business Home 704-663-6860

ADDRESS 168 Woodridge Ln Mooresville NC 28115

LOCATION I-5 N TR Mazeppa TL Woodridge Next to last on right

SUBDIVISION Woodridge BLOCK / SECTION LOT 13 LOT AREA SITE CLASS. PS DESIGN FLOW 240 gpd L.T.A.R. .25 gpd/ft²

Septic Tank: Existing Gallons: STB Date

Pump Tank: 1000 min Gallons: PT 345 Date 11-10-07

Pump Make: Zoeller Model 140 Serial No.

Nitrification Field: No Fields 2 Square Feet 480 Linear Feet 276 ★

No Lines 3 Ring Trench Width 12-18" Ring Max Trench Bottom Depth Ring 24" Gravel Depth 12"

☐ New System ☒ Repair ☐ Expansion System Type: I II (III) IV V VI

System Description: Ring 1201 & conventional

Repair System Description:

Maintenance Agreement Required: ☐ Yes ☒ No

☒ House/Mod. Home No. Bedrooms 4

☐ Mobile Home No. Persons 8

☐ Business No. Employees

☐ Other

Water Supply: ☒ Individual ☐ Public ☐ Community

☐ Gravity ☒ Pressure ☐ Slab ☒ Crawl Space ☐ Basement w/plumbing ☐ Basement wo/plumbing

#4 HP

Comments: 3 conv, 36" conv, conv, 30"

★ Ring 3@50 ft, conv. 3@42 ft.

Comments:/Conditions:


1250 gal. pumptank

Rhombus


Timex set for on@7min 15sec one time per day

No alarm

INITIAL SITE SKETCH

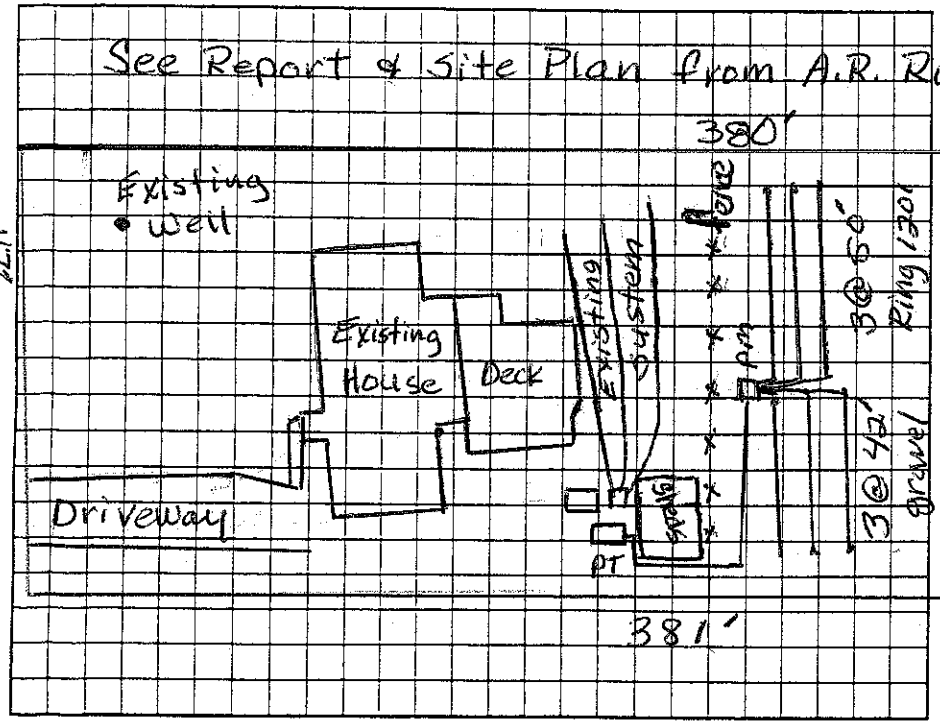

AS BUILT SKETCH

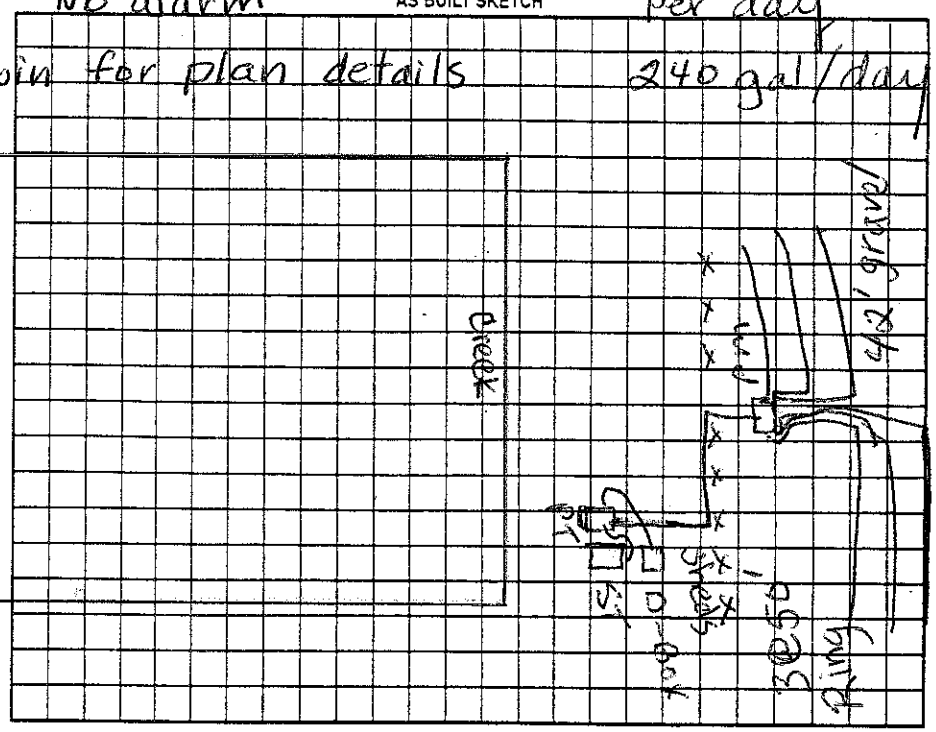

Permit can be suspended or revoked if any false information is supplied toward securing the permit/any unauthorized changes are made to the site/any unauthorized changes are made in the installation of the system. Improvement Permit with plat valid without expiration ☐ Improvement Permit with site plan valid for sixty months ☒ Authorization to Construct is valid for a period equal to that of Improvement Permit – not to exceed sixty months.

Signed: Linda Honeycutt date 12-10-07 Installed by: R&H

Improvement Permit by: Judy Melville date 12-10-07 Operation Permit by: Judy Melville date 12-14-07

Authorization to Construct by: Judy Melville date 12-10-07 Existing System Inspection by: date

HEALTH DEPT. COPY: WHITE OWNER COPY (FINAL): YELLOW OWNER COPY (INITIAL): PINK