IREDELL COUNTY HEALTH DEPARTMENT

STATESVILLE 704-878-5305 MOORESVILLE 704-664-5281

IMPROVEMENT PERMIT / AUTHORIZATION TO CONSTRUCT / OPERATION PERMIT / EXISTING SYSTEM INSPECTION

PERMIT# ~~7748~~ 90570 PIN# 4666861429 DATE 6/22/2000

OWNER OR CONTRACTOR Donald & Gail Blais PHONE: Business Home 483-9884

ADDRESS 6254 Hwy 150 East Denver NC 28037

LOCATION Highway 150 E TL Overhead Bridge Rd TR Scotland Dr. 2nd Street TR Brigadoon at end

SUBDIVISION ~~Highland Crossing~~ BLOCK / SECTION LOT 21 LOT AREA .96 Acre SITE CLASS. PS DESIGN FLOW 360 gpd L.T.A.R. .25 - .3

Septic Tank: 1000 Gallons: STB 1012 Date 4-30-00 ☒ New System ☐ Repair System Type: I, II, III, IV, V, VI ☒ House/Mod. Home No. Bedrooms 3

Pump Tank: Gallons: PT Date ☐ Mobile Home No. Bathrooms 2

Pump Make: Model Serial No. ☐ Business No. Employees

Nitrification Field: No Fields 1 Square Feet 1200'+ Linear Feet 400'+ ☐ Other

No Lines 4 at 100'+ Trench Width 36" Max Trench Bottom Depth 18" Gravel Depth 12" ☐ Slab ☒ Crawl Space ☐ Basement w/plumbing ☐ Basement wo/plumbing

System Description: Gravity - Conventional

Repair System Description: Gravity - Innovative

Maintenance Agreement Required: ☐ Yes ☒ No

Water Supply: ☒ Individual ☐ Public ☐ Community


Comments:/Conditions: Keep Septic System at least 10' From PL, 5' From House & 50' to 100' From any well.

Comments:/Conditions: Potential well site


Filter & riser installed

Scale 1:40

INITIAL SITE SKETCH

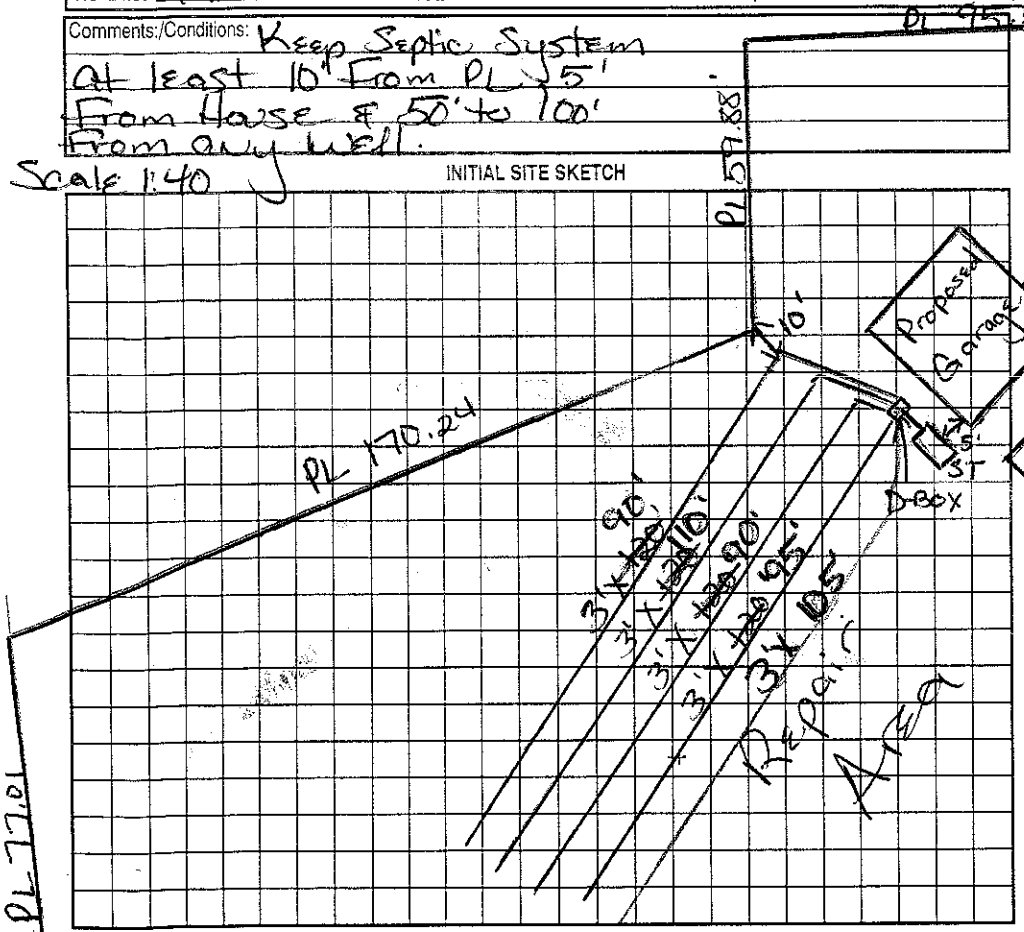

AS BUILT SKETCH

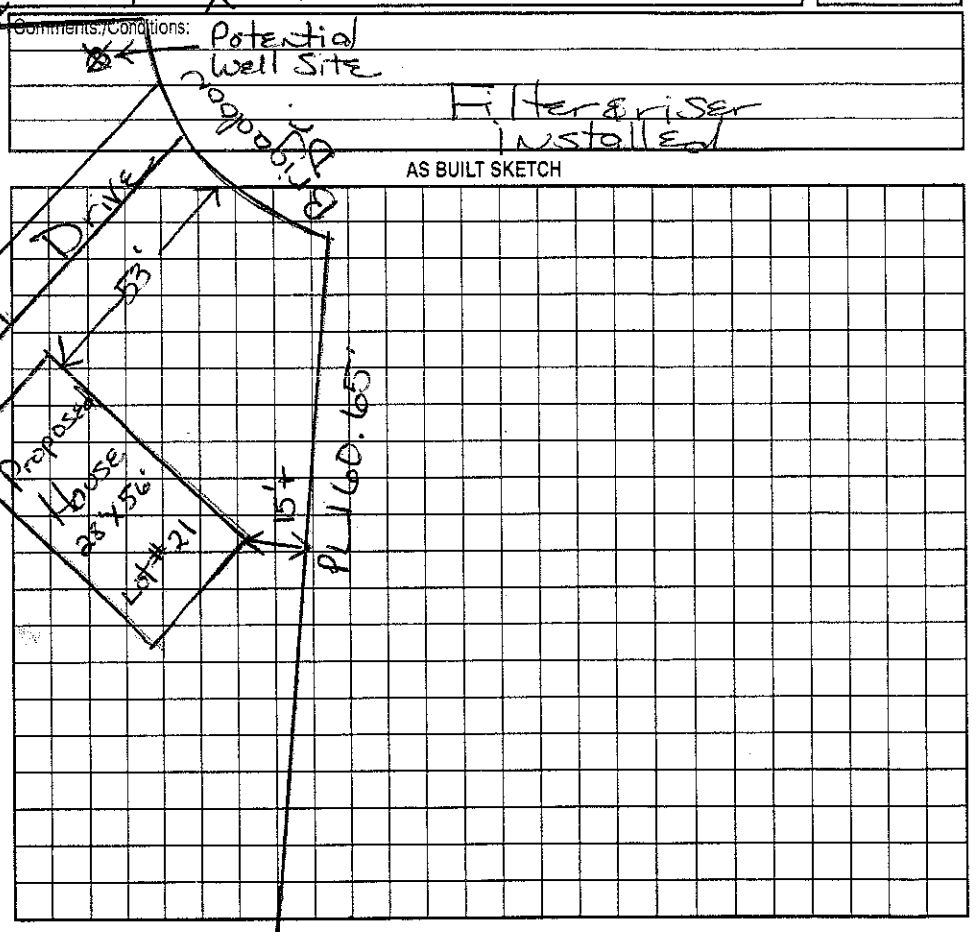

Permit can be suspended or revoked if any false information is supplied toward securing the permit/any unauthorized changes are made to the site/any unauthorized changes are made in the installation of the system. Improvement Permit with plat valid without expiration. Improvement Permit with site plan valid for sixty months. Authorization to Construct is valid for a period equal to that of Improvement Permit – not to exceed sixty months.

Signed: X Gail S. Blais date

Improvement Permit by: Maria H. Dotson RS date 6/22/00

Authorization to Construct by: Maria H. Dotson RS date 6/22/00

Installed by: Grizzly Grading

Operation Permit by: Maria H. Dotson RS date 8/4/2000

Existing System Inspection by: date

HEALTH DEPT. COPY: WHITE OWNER COPY (FINAL): YELLOW OWNER COPY (INITIAL): PINK