IREDELL COUNTY HEALTH DEPARTMENT

STATESVILLE 704-878-5305 MOORESVILLE 704-664-5281

IMPROVEMENT PERMIT / CERTIFICATE OF COMPLETION / OPERATION PERMIT / EXISTING SYSTEM INSPECTION

PROPERTY DESCRIPTION NO. 2406 DATE 10/20/93 TAX MAP NO. 1N 11 A 20 Watershed: ☑ Yes ☐ No

OWNER OR CONTRACTOR MARK GREEN PHONE: Business ~~Home~~ 4668-61-1741

ADDRESS Rt 1c Box 218 MOORESVILLE, NC.

LOCATION 150 E TL OVERHEAD BRIDGE RD, TR TO LOT ON (L) OF 2ND CULDESAC ON (R) SIDE

SUBDIVISION HIGHLAND CROSSING BLOCK / SECTION NA LOT 20 LOT AREA ~ .97 AC SITE CLASS. D DESIGN FLOW 450 L.T.A.R. .275

Septic Tank: 1000 Gallons; STB 782 Date 10/20/93
Pump Tank: ____ Gallons; PT ____ Date ____
Pump Make: ____ Model ____ Serial No. ____
Nitrification Field: No Fields 1 Square Feet 1745 Linear Feet 581
No Lines 4 Trench Width 3' Max Trench Bottom Depth ~~X~~ 24" Gravel Depth 12"

☑ New System ☐ Repair System Type: I, (II) III, IV, V, VI
System Description: CONV. (SHALLOW)
Repair System Description: CONV (SHALLOW)
Maintenance Agreement Required: ☐ Yes ☐ No

☑ House/Mod. Home No. Bedrooms 4
☐ Mobile Home No. Bathrooms 2.5
☐ Business No. Employees ____
☐ Other ____


☐ Slab ☑ Crawl Space ☐ Basement w/plumbing ☐ Basement w/o plumbing

Water Supply:
☑ Individual
☐ Community
☐ Public


Comments: KEEP PLUMBING VERY SHALLOW - DRAINFIELD LOCATED IN AREA SHOWN HERE. CLEANOUTS REQUIRED SCOTLAND DR.

Comments:

INITIAL SITE SKETCH

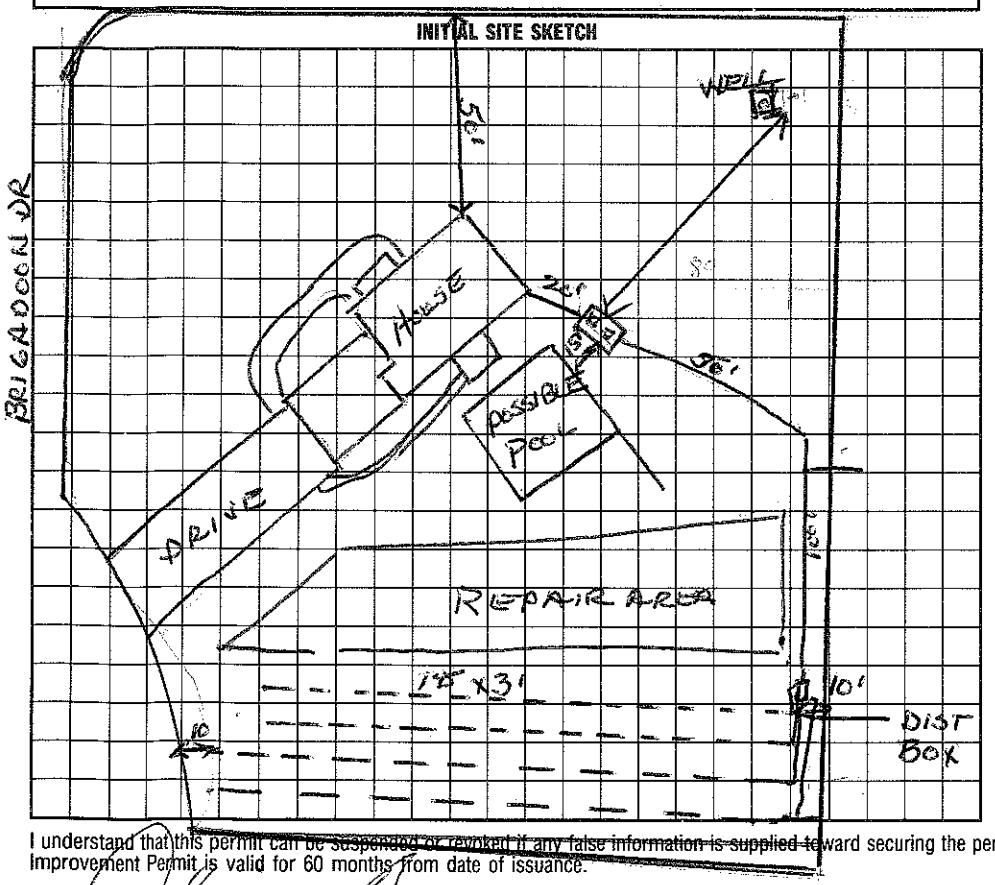

AS BUILT SKETCH

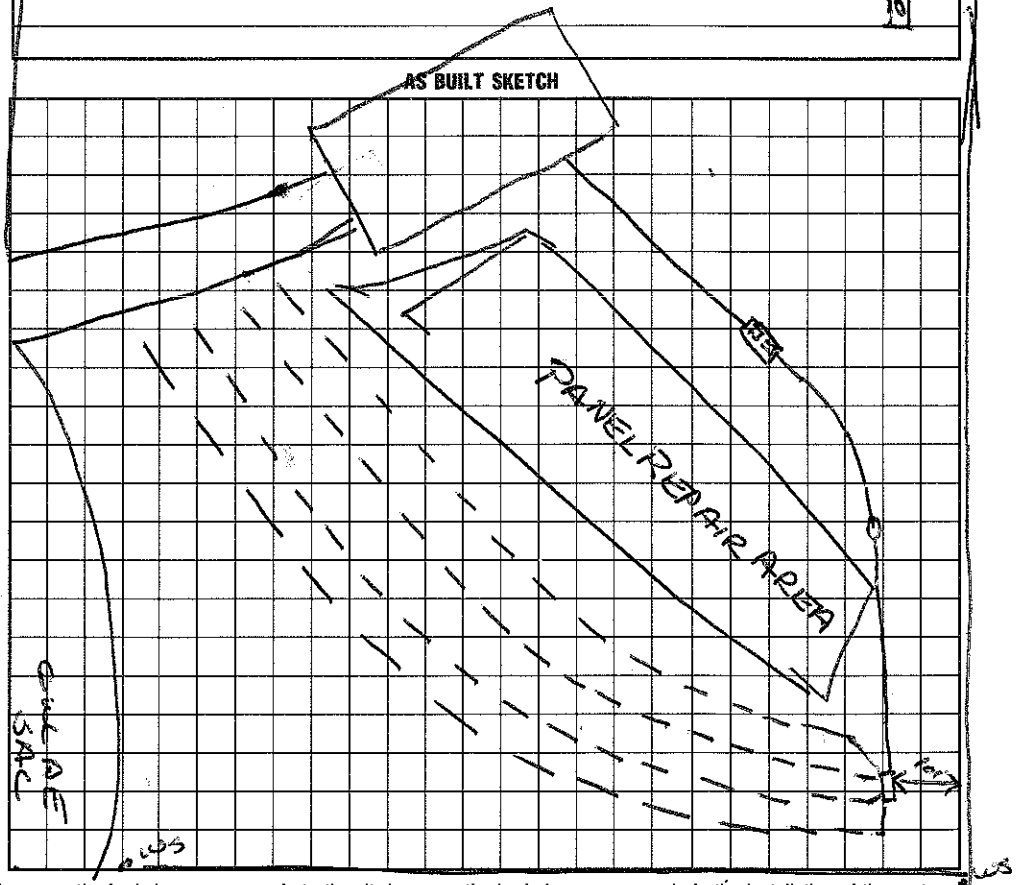

I understand that this permit can be suspended or revoked if any false information is supplied toward securing the permit/any unauthorized changes are made to the site/any unauthorized changes are made in the installation of the system. Improvement Permit is valid for 60 months from date of issuance.

Signed John D. Brown

Improvement Permit by: Wesley Sparks RS. date 10/20/93

Existing System Inspection by: ____ date ____

Installed by: LARRY TUCKER

Certificate of Completion by: Wesley Sparks RS date 11/30/93

Operation Permit by: ____ date ____

HEALTH DEPT. COPY: WHITE INSPECTION COPY (FINAL): GREEN OWNER COPY (FINAL): YELLOW INSPECTION COPY (INITIAL): PINK OWNER COPY (INITIAL): GOLD