IREDELL COUNTY HEALTH DEPARTMENT

STATESVILLE 704-878-5305 MOORESVILLE 704-664-5281

IMPROVEMENT PERMIT / AUTHORIZATION TO CONSTRUCT / OPERATION PERMIT / EXISTING SYSTEM INSPECTION

PERMIT# 7731 (90524) PIN# 4668 61 3349 DATE 6/7/00

OWNER OR CONTRACTOR Donald Ekberg PHONE: Business Home 664-1548

ADDRESS Bright Star Circle Mooresville, NC. 28115

LOCATION 150 E TL Overhead Bridge Rd. TR Scotland Dr. TR Bright Star Circle to cul de sac on (R)

SUBDIVISION HIGHLAND CROSSING BLOCK / SECTION LOT 17 LOT AREA .92 AC SITE CLASS. PS DESIGN FLOW 360 L.T.A.R. .3

Septic Tank: 1000 Gallons; STB 1017 Date

Pump Tank: Gallons; PT Date

Pump Make: Model Serial No.

Nitrification Field: No Fields 1 Square Feet 1200 Linear Feet 400

No Lines @ 50 & 3' Trench Width 36" Max Trench Bottom Depth 36" Gravel Depth 12"

[X] New System [ ] Repair System Type: I, [II], III, IV, V, VI

System Description: Gravel - Conventional

Repair System Description: None

Maintenance Agreement Required: [ ] Yes [X] No

[X] House/Mod. Home No. Bedrooms 3

[ ] Mobile Home No. Bathrooms 2

[ ] Business No. Employees

[ ] Other

[ ] Slab [X] Crawl Space [ ] Basement w/plumbing [ ] Basement wo/plumbing


Water Supply: [X] Individual [ ] Public [ ] Community

Comments:/Conditions:


Comments:/Conditions:

(1" = 50')

INITIAL SITE SKETCH

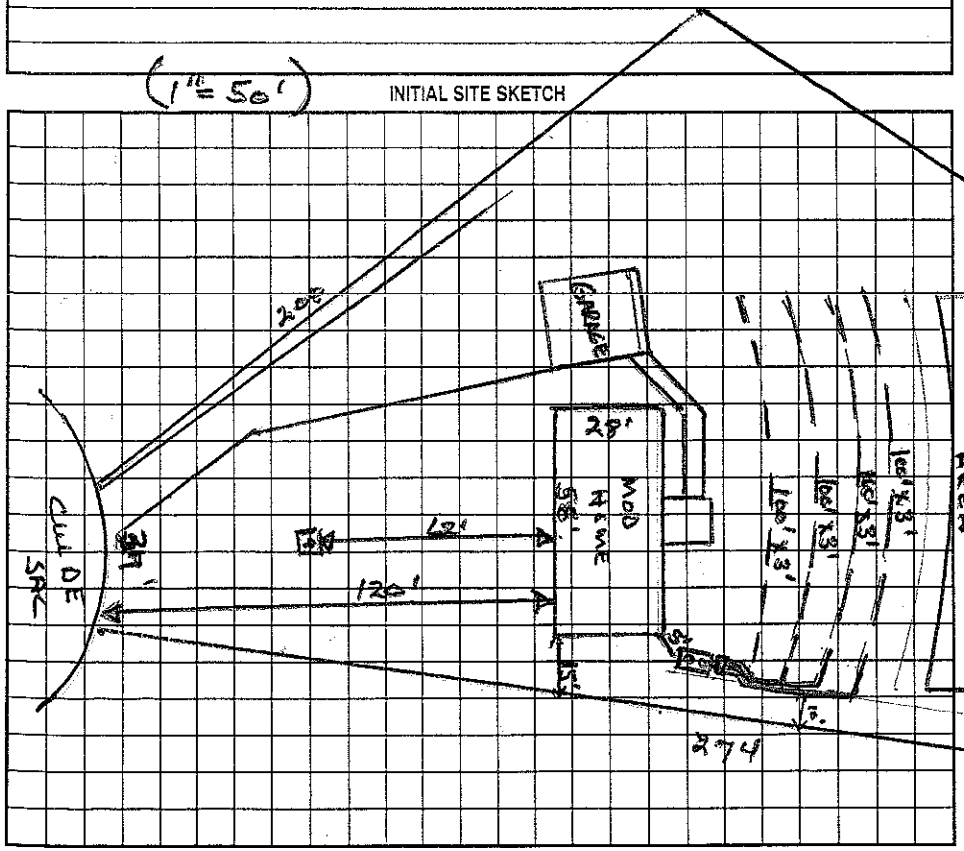

AS BUILT SKETCH

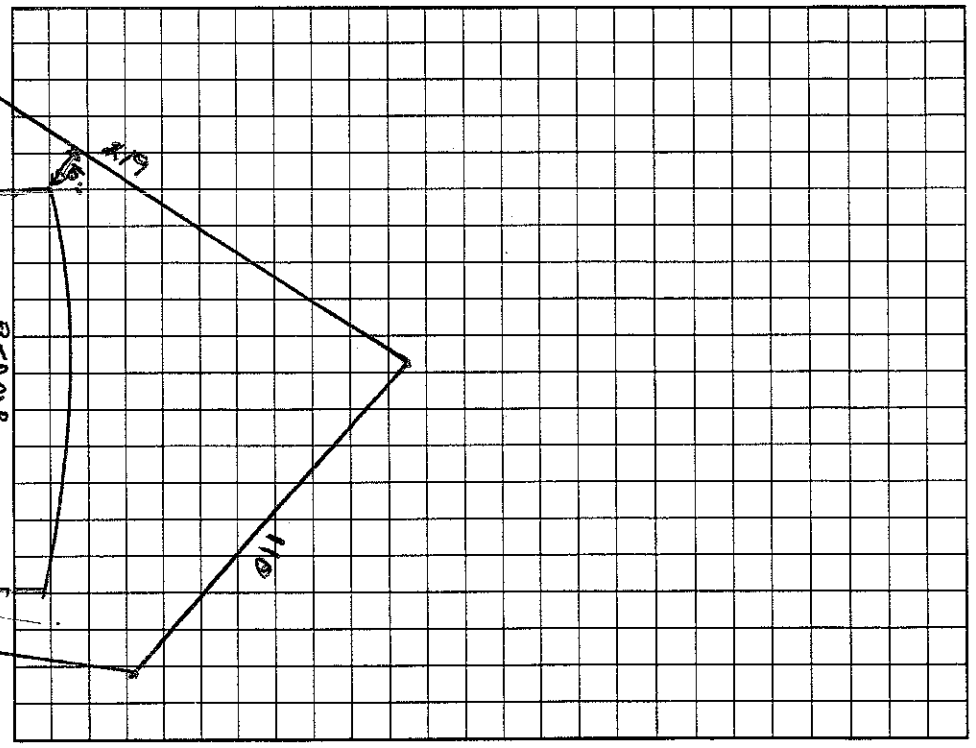

Permit can be suspended or revoked if any false information is supplied toward securing the permit/any unauthorized changes are made to the site/any unauthorized changes are made in the installation of the system. Improvement Permit with plat valid without expiration. Improvement Permit with site plan valid for sixty months. Authorization to Construct is valid for a period equal to that of Improvement Permit – not to exceed sixty months.

Signed: * Donald W Ekberg date 6/7/00

Improvement Permit by: Wesley Sparks RS. date 6/7/00

Authorization to Construct by: Wesley Sparks RS. date 6/7/00

Installed by: Lewis Nance

Operation Permit by: Wesley Sparks RS. date 7/24/00

Existing System Inspection by: date

HEALTH DEPT. COPY: WHITE OWNER COPY (FINAL): YELLOW OWNER COPY (INITIAL): PINK