IREDELL COUNTY HEALTH DEPARTMENT

STATESVILLE 704-878-5305 MOORESVILLE 704-664-5281

IMPROVEMENT PERMIT / AUTHORIZATION TO CONSTRUCT / OPERATION PERMIT / EXISTING SYSTEM INSPECTION

PERMIT# 110829 PIN# 4668 61 3780 DATE 8/19/03

OWNER OR CONTRACTOR Kelly Fostadt PHONE: Business 258-7925 Home

ADDRESS 142 Scotland Dr. Mooresville, NC. 28115 168 SCOTLAND DR.

LOCATION Hwy 150 East TL Overhead Bridge TR Scotland on corner of Scotland & Brightstar

SUBDIVISION Highland Crossing BLOCK / SECTION LOT 19 LOT AREA ~40,000 FT² SITE CLASS. PS DESIGN FLOW 360 L.T.A.R. .3

Septic Tank: 1000 Gallons; STB 794 Date 1/24/03
Pump Tank: Gallons; PT Date
Pump Make: Model Serial No.
Nitrification Field: No Fields 1 Square Feet 900 Linear Feet 300
No Lines 3@100' Trench Width 3' Max Trench Bottom Depth 3' Gravel Depth N/A

[X] New System [ ] Repair System Type: I, II, (III) IV, V, VI
System Description: GRAVITY - 25% Reduced
Repair System Description: Pump - Innovative
Maintenance Agreement Required: [ ] Yes [X] No


[X] House/Mod. Home No. Bedrooms 3
[ ] Mobile Home No. Bathrooms 2
[ ] Business No. Employees
[ ] Other
[ ] Slab [X] Crawl Space [ ] Basement w/plumbing [ ] Basement wo/plumbing

Water Supply: [X] Individual [ ] Public [ ] Community

Comments:/Conditions:

Comments:/Conditions:

INITIAL SITE SKETCH

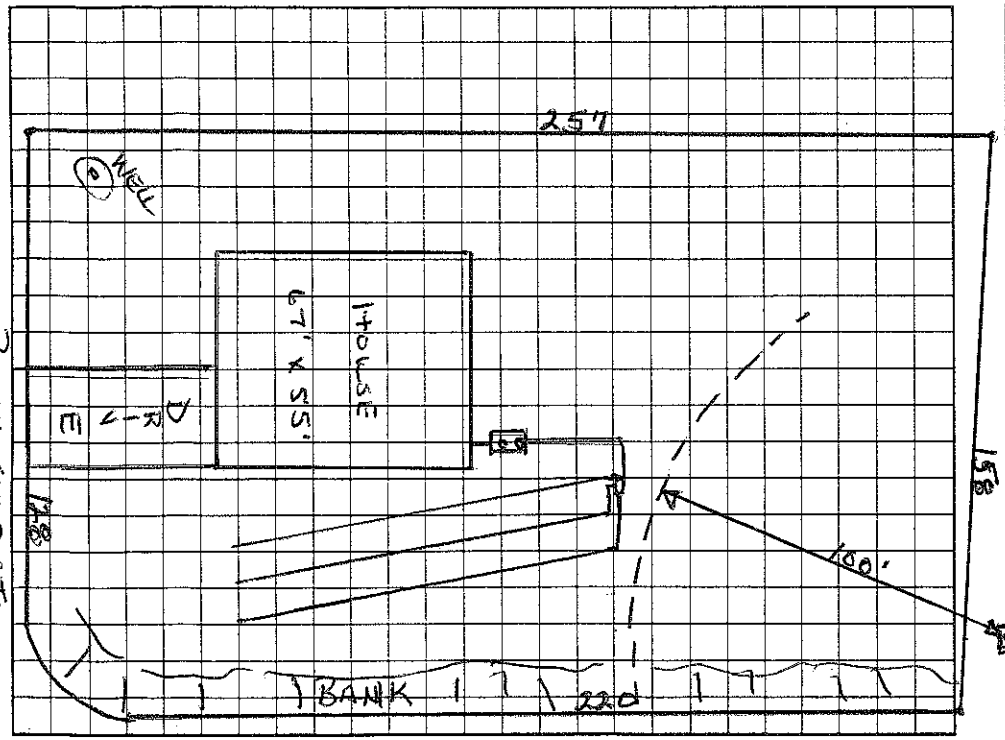

AS BUILT SKETCH

Permit can be suspended or revoked if any false information is supplied toward securing the permit/any unauthorized changes are made to the site/any unauthorized changes are made in the installation of the system. Improvement Permit with plat valid without expiration. Improvement Permit with site plan valid for sixty months. Authorization to Construct is valid for a period equal to that of Improvement Permit – not to exceed sixty months.

Signed: X date

Improvement Permit by: date

Authorization to Construct by: date

Installed by: McLeod Const.

Operation Permit by: Wesley Sparks RS. date 8/19/03

Existing System Inspection by: date

HEALTH DEPT. COPY: WHITE OWNER COPY (FINAL): YELLOW OWNER COPY (INITIAL): PINK