IREDELL COUNTY HEALTH DEPARTMENT

STATESVILLE 704-878-5305 MOORESVILLE 704-664-5281

IMPROVEMENT PERMIT / CERTIFICATE OF COMPLETION / OPERATION PERMIT / EXISTING SYSTEM INSPECTION

11:30

PROPERTY DESCRIPTION NO. 5132 DATE 10-30-97 TAX MAP NO. 4711-A-12 Watershed: ☐ Yes ☒ No

OWNER OR CONTRACTOR Greg D. Smith Dev. Group PHONE: Business (704) 892-0909 Home 4668-61-5996

ADDRESS P.O. Box 1908 Davidson, NC 28036

LOCATION East on Hwy 150 TL on Overhead Bridge Rd TR Scotland Dr. 7th lot on left

SUBDIVISION Highland Crossing BLOCK / SECTION ____ LOT 12 LOT AREA 40,697 SITE CLASS. PS DESIGN FLOW 360gpd L.T.A.R. .38-.3

Septic Tank: 1000 Gallons; STB 794 Date 3/19/98

Pump Tank: ____ Gallons; PT ____ Date ____

Pump Make: ____ Model ____ Serial No. ____

Nitrification Field: ☐ No Fields ____ Square Feet ____ Linear Feet 430'

No Lines 4 5 Trench Width 36" Max Trench Bottom Depth 36" Gravel Depth 12"

☒ New System ☐ Repair System Type: I, II, III, IV, V, VI

System Description: Grav. Conventional

Repair System Description: (Shallow) Pump-Conv.

Maintenance Agreement Required: ☐ Yes ☒ No

☒ House/Mod. Home No. Bedrooms 3

☐ Mobile Home No. Bathrooms 2.5

☐ Business No. Employees ____

☐ Other ____

☐ Slab ☒ Crawl Space ☐ Basement w/plumbing ☐ Basement wo/plumbing


Water Supply: ☒ Individual ☐ Community ☐ Public

Comments: Keep house ~ 145' from Road & 5' from Septic System. Must keep Drainlines out of Drainageway Use Drop boxes.

Comments:

INITIAL SITE SKETCH

Scale 1:100

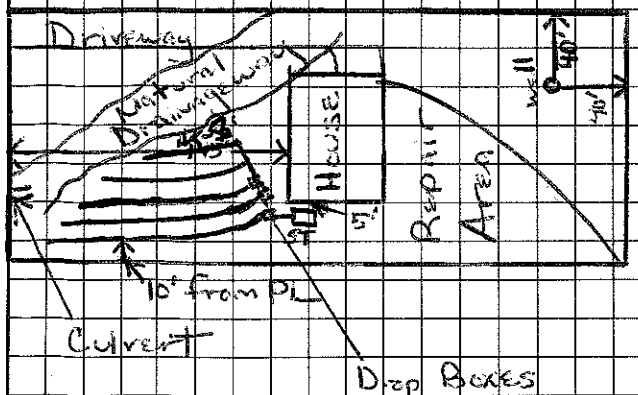

AS BUILT SKETCH

I understand that this permit can be suspended or revoked if any false information is supplied toward securing the permit/any unauthorized changes are made to the site/any unauthorized changes are made in the installation of the system. Improvement Permit is valid for 60 months from date of issuance.

Signed: Gregory E. Smith

Improvement Permit by: Maria H. Watson date 10/30/97

Existing System Inspection by: Maria H. Watson date 10/30/97

Construction Auth.

Installed by: Buddy Chaney

Certificate of Completion by: Wesley Speck RS. date 5/20/98

Operation Permit by: Wesley Speck RS. date 5/20/98

HEALTH DEPT. COPY: WHITE INSPECTION COPY (FINAL): GREEN OWNER COPY (FINAL): YELLOW INSPECTION COPY (INITIAL): PINK OWNER COPY (INITIAL): GOLD