4:00

IREDELL COUNTY HEALTH DEPARTMENT

STATESVILLE 704-878-5305 MOORESVILLE 704-664-5281

IMPROVEMENT PERMIT / AUTHORIZATION TO CONSTRUCT / OPERATION PERMIT / EXISTING SYSTEM INSPECTION

PERMIT# 6008 PIN# 4668 61 6469 DATE 11/2/99

OWNER OR CONTRACTOR Michael Branch PHONE: Business 664-7062 Home

ADDRESS 702 N Main St. Mooresville NC. 28115

LOCATION Overhead Bridge Rd. TR Highland Crossing TR Brightstar on (L) off the cul de sac

SUBDIVISION HIGHLAND CROSSING BLOCK / SECTION LOT 15 LOT AREA 20,000 FT² SITE CLASS. PS DESIGN FLOW 360 L.T.A.R. .3

Septic Tank: 1000 Gallons; STB 1012 Date 9/30/99
Pump Tank: 1000 Gallons; PT Date 11/4/99
Pump Make: HYDROMATIC Model SHEF 40A1 Serial No. 6/99
Nitrification Field: No Fields 1 Square Feet 900 Linear Feet 300
No Lines 4@75'&3' Trench Width 36" Max Trench Bottom Depth 36" Gravel Depth SAND.

☒ New System ☐ Repair System Type: I, II, (III), IV, V, VI
System Description: PressMan-HOS on Ch. Plastic
Repair System Description: SAME
Maintenance Agreement Required: ☐ Yes ☒ No


☒ House/Mod. Home No. Bedrooms 3
☐ Mobile Home No. Bathrooms 2
☐ Business No. Employees
☐ Other
☐ Slab ☒ Crawl Space ☐ Basement w/plumbing ☐ Basement wo/plumbing

Water Supply: ☒ Individual ☐ Public ☐ Community

Comments:/Conditions:

Comments:/Conditions: 12/2/99 Pump tank full to alarm point.

INITIAL SITE SKETCH

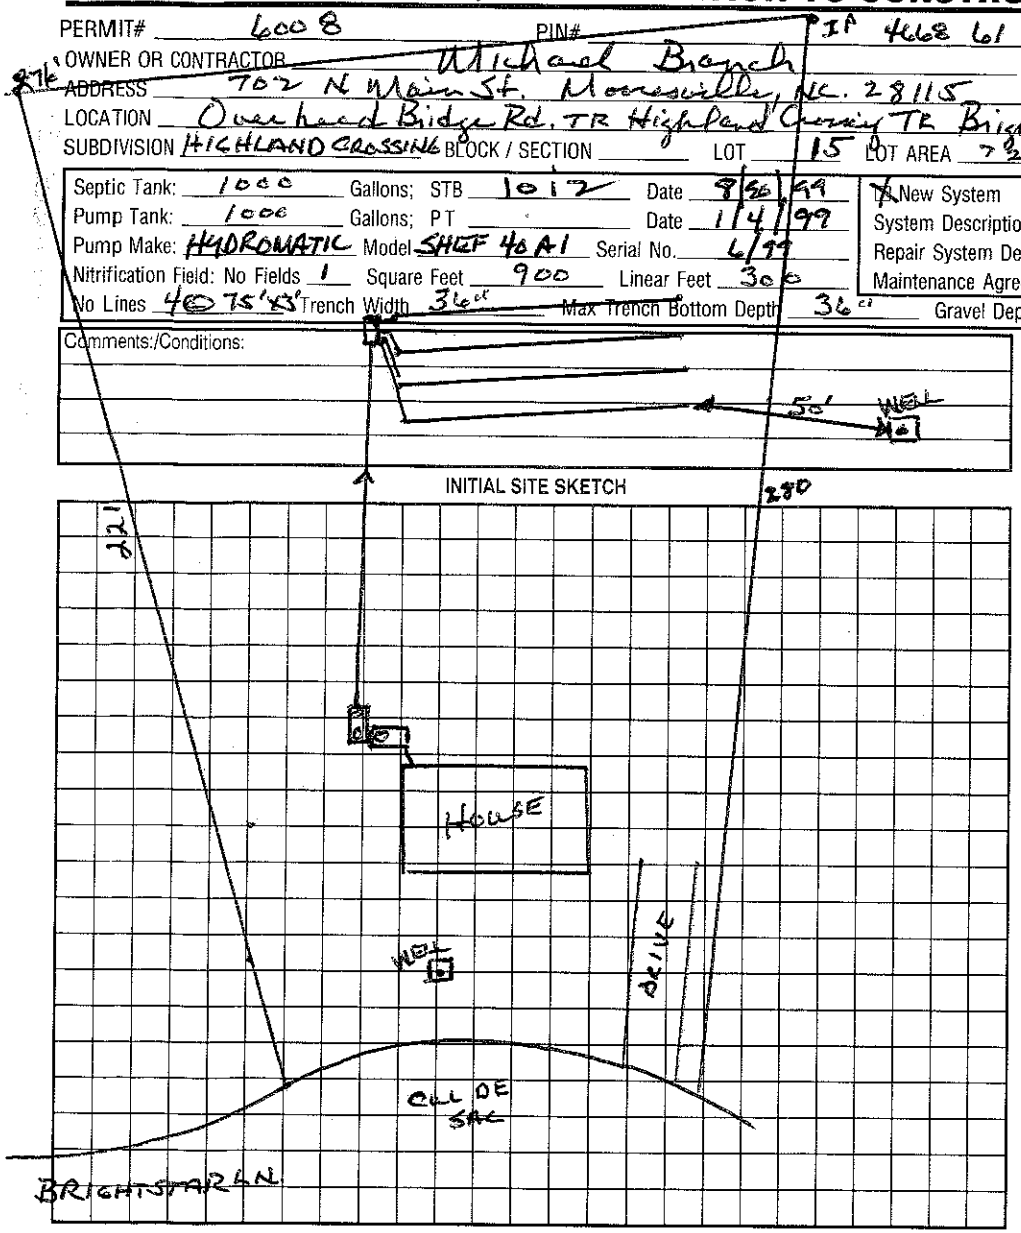

AS BUILT SKETCH

Permit can be suspended or revoked if any false information is supplied toward securing the permit/any unauthorized changes are made to the site/any unauthorized changes are made in the installation of the system. Improvement Permit with plat valid without expiration. Improvement Permit with site plan valid for sixty months. Authorization to Construct is valid for a period equal to that of Improvement Permit – not to exceed sixty months.

Signed: * Keith Callicutt C&W Grading Septic date 11-3-99 Installed by: C+W Grading

Improvement Permit by: Wesley Sparks RS. date 11/2/99 Operation Permit by: Wesley Sparks RS. date 12/2/99

Authorization to Construct by: Wesley Sparks RS. date 11/2/99 Existing System Inspection by: date

HEALTH DEPT. COPY: WHITE OWNER COPY (FINAL): YELLOW OWNER COPY (INITIAL): PINK