(9:30) ~~4~~

IREDELL COUNTY HEALTH DEPARTMENT

STATESVILLE 704-878-5305 MOORESVILLE 704-664-5281

IMPROVEMENT PERMIT / CERTIFICATE OF COMPLETION / OPERATION PERMIT / EXISTING SYSTEM INSPECTION

PROPERTY DESCRIPTION NO. 3010 DATE 5/5/97 TAX MAP NO. 1N11A/14 Watershed: ☑ Yes ☐ No

OWNER OR CONTRACTOR BRIGHT STAR DEVELOPMENT PHONE: Business ~~Home~~ 4668-61-6667

ADDRESS RT 7 Box 712 MOORESVILLE

LOCATION BRIGHT STAR CIRCLE

SUBDIVISION ~~HIGHLAND CROSSING~~ BLOCK / SECTION LOT 14 LOT AREA 40,098 AC. SITE CLASS. RS DESIGN FLOW 360 GPD L.T.A.R. .36 PD/FT

Septic Tank: 1000 Gallons; STB 794 Date 4/9/97

Pump Tank: Gallons; PT Date

Pump Make: Model Serial No.

Nitrification Field: No Fields 1 Square Feet 900 Linear Feet 300

No Lines 5 @ 60' Trench Width 36" Max Trench Bottom Depth ~~24~~ 24" Gravel Depth N/A

☑ New System ☐ Repair System Type: I, II, (III), IV, V, VI

System Description: GRAVITY CHAMBERED

Repair System Description: PUMP CHAMBERED

Maintenance Agreement Required: ☐ Yes ☑ No

☑ House/Mod. Home No. Bedrooms 3

☐ Mobile Home No. Bathrooms 2

☐ Business No. Employees

☐ Other

☐ Slab ☑ Crawl Space ☐ Basement w/plumbing ☐ Basement wo/plumbing


Water Supply: ☑ Individual ☐ Community ☐ Public

Comments:

Comments:

HIGH LAND CROSSING

INITIAL SITE SKETCH

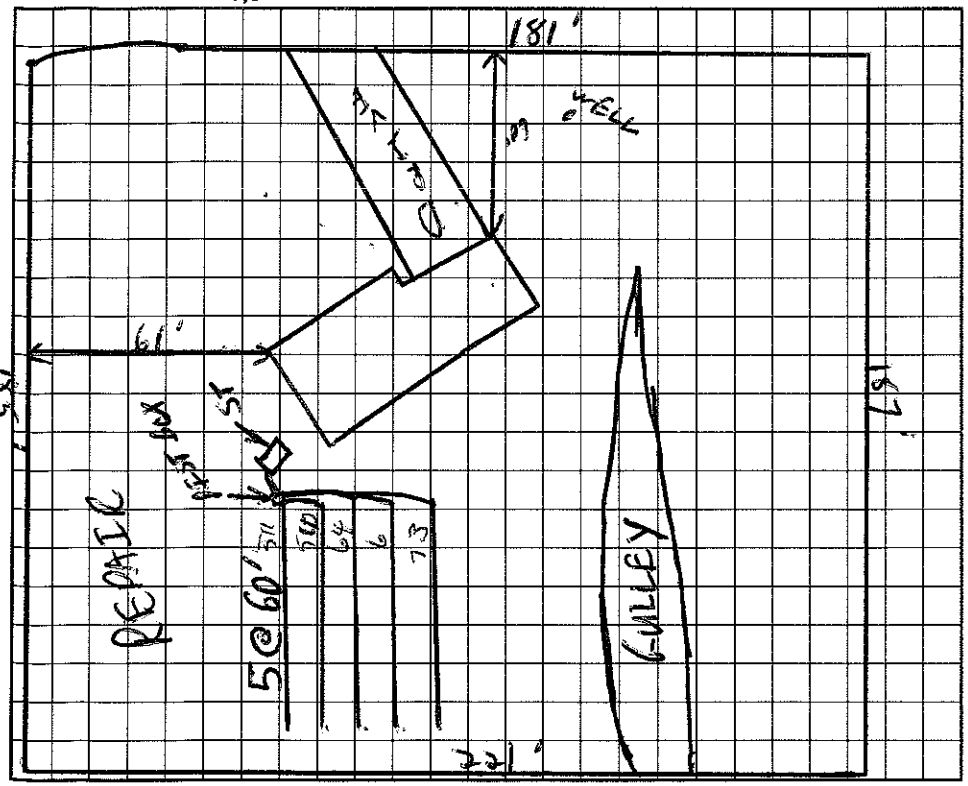

BRIGHT STAR CIRCLE

AS BUILT SKETCH

Same as Site sketch

I understand ~~that~~ this permit can be suspended or revoked if any false information is supplied toward securing the permit/any unauthorized changes are made to the site/any unauthorized changes are made in the installation of the system. Improvement Permit is valid for 60 months from date of issuance.

Signed

Improvement Permit by: C. Ray Zoon date 5/5/97

~~Authorization for~~ Existing System Inspection by: C. Ray Zoon date 6/5/97

TO CONSTR

Installed by: JULIAN BOWLES

Certificate of Completion by: date

Operation Permit by: C. Ray Zoon date 6/23/97

HEALTH DEPT. COPY: WHITE INSPECTION COPY (FINAL): GREEN OWNER COPY (FINAL): YELLOW INSPECTION COPY (INITIAL): PINK OWNER COPY (INITIAL): GOLD