IREDELL COUNTY HEALTH DEPARTMENT

STATESVILLE 704-878-5305 MOORESVILLE 704-664-5281

IMPROVEMENT PERMIT / CERTIFICATE OF COMPLETION / OPERATION PERMIT / EXISTING SYSTEM INSPECTION

PROPERTY DESCRIPTION NO. 2649 DATE 10/4/94 TAX MAP NO. 1N 11 A 13

OWNER OR CONTRACTOR Brightstar Development

ADDRESS Rt 7 Box 712 Mooresville, NC. 28115 PHONE: Business 4668-61-7927 Home 664-0809

LOCATION end of Scotland Rd. on (L) Watershed: ☑ Yes ☐ No

SUBDIVISION Highland Crossing BLOCK / SECTION LOT 13 LOT AREA 43,000 ± SITE CLASS. P DESIGN FLOW 360 L.T.A.R. .3-.35

Septic Tank: 1000 Gallons; STB 794 Date 9/27/94

Pump Tank: Gallons; PT Date

Pump Make: Model Serial No.

Nitrification Field: No Fields 1 Square Feet 1200 Linear Feet 400'

No Lines 4 or 5 Trench Width 36" Max Trench Bottom Depth 24-26" Gravel Depth 12"

☑ New System ☐ Repair System Type: I, (II), III, IV, V, VI

System Description: Deep Bed - Conventional

Repair System Description:

Maintenance Agreement Required: ☐ Yes ☑ No

☑ House/Mod. Home ☐ Mobile Home ☐ Business ☐ Other

No. Bedrooms 3 No. Bathrooms 2 No. Employees


☐ Slab ☑ Crawl Space ☐ Basement w/plumbing ☐ Basement wo/plumbing

Water Supply: ☑ Individual ☐ Community ☐ Public

Comments: Trench depth 24-26" Follow contours as shown ◎ WELL

Comments: Installed as per talk as drawn.

INITIAL SITE SKETCH

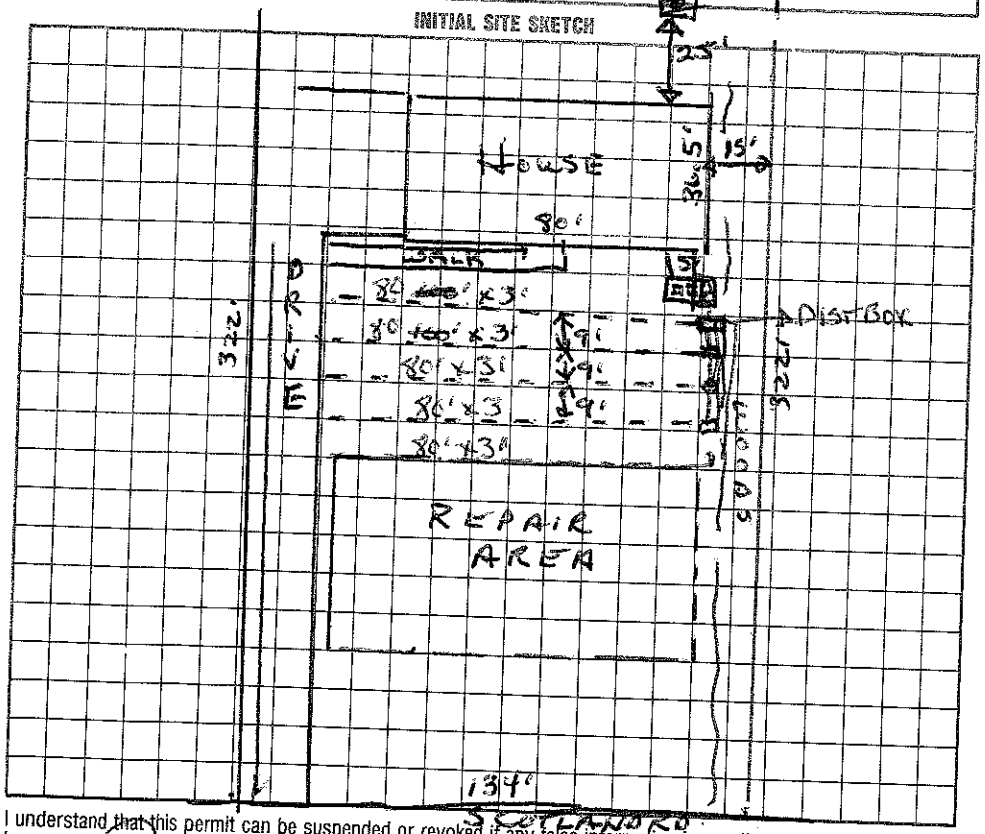

AS BUILT SKETCH

I understand that this permit can be suspended or revoked if any false information is supplied toward securing the permit/any unauthorized changes are made to the site/any unauthorized changes are made in the installation of the system. Improvement Permit is valid for 60 months from date of issuance.

Signed: John J Brown

Improvement Permit by: Wesley Sparks R.S. date 10/4/94

Existing System Inspection by: date

Installed by: JR Bowles

Certificate of Completion by: Wesley Sparks R.S. date 11/22/94

Operation Permit by: date

HEALTH DEPT. COPY: WHITE INSPECTION COPY (FINAL): GREEN OWNER COPY (FINAL): YELLOW INSPECTION COPY (INITIAL): PINK OWNER COPY (INITIAL): GOLD