IREDELL COUNTY HEALTH DEPARTMENT

TATESVILLE 704-878-5305 MOORESVILLE 704-664-5281

IMPROVEMENT PERMIT / AUTHORIZATION TO CONSTRUCT / OPERATION PERMIT / EXISTING SYSTEM INSPECTION

PERMIT# 6563 PIN# 4668 62 2087 DATE 5/11/99

OWNER OR CONTRACTOR Louis Barba PHONE: Business 892-5124 Home

ADDRESS 694 Dail Ct. Elmont, N.Y. 11003

LOCATION 150 E TL Overhead Bridge Rd. TR Scotland Drive TL Brigadoon Dr., 2ND lot on (R)

SUBDIVISION Highland Crossing BLOCK / SECTION LOT 9 LOT AREA 41278 FT² SITE CLASS PS DESIGN FLOW 360 L.T.A.R. .3

Septic Tank: 1000 Gallons; STB 794 Date 5-31-99
Pump Tank: Gallons; PT Date
Pump Make: Model Serial No.
Nitrification Field: No Fields 1 Square Feet 1200 Linear Feet 400
No Lines 4 Trench Width 36" Max Trench Bottom Depth 30" Gravel Depth 12"

☒ New System ☐ Repair System Type: I, (II), III, IV, V, VI
System Description: Gravity Conventional
Repair System Description: Chlorination HDS
Maintenance Agreement Required: ☐ Yes ☒ No

☒ House/Mod. Home No. Bedrooms 3
☐ Mobile Home No. Bathrooms 2
☐ Business No. Employees
☐ Other


☐ Slab ☒ Crawl Space ☐ Basement w/plumbing ☐ Basement wo/plumbing

Water Supply: ☒ Individual ☐ Public ☐ Community

Comments/Conditions: Filter & riser installed
Checked lines 3 & 4 in AM okay ML
Lines 1 & 2 need to be reinstalled


9/24

INITIAL SITE SKETCH (1"=50')

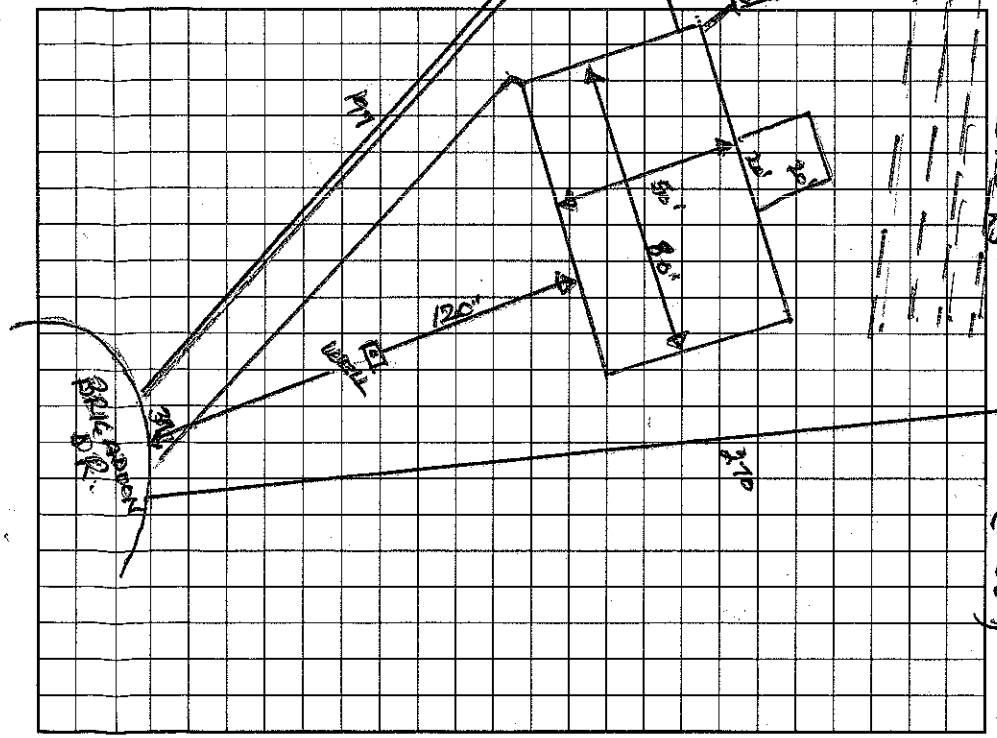

Comments/Conditions:

AS BUILT SKETCH (1"=50')

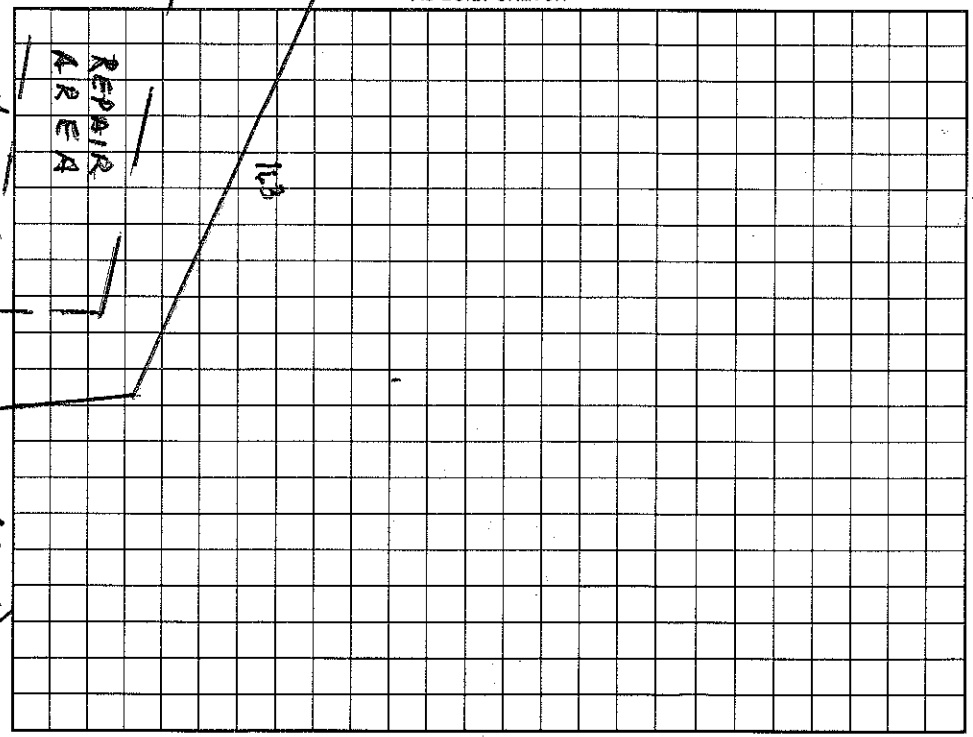

Permit can be suspended or revoked if any false information is supplied toward securing the permit/any unauthorized changes are made to the site/any unauthorized changes are made in the installation of the system. Improvement Permit with plat valid without expiration. Improvement Permit with site plan valid for sixty months. Authorization to Construct is valid for a period equal to that of Improvement Permit – not to exceed sixty months.

Signed: [signature] date 5/26/99 Installed by: A. Cornelius Grading

Improvement Permit by: Wesley Sparks R.S. date 5/11/99 Operation Permit by: Maria H. Hankins R.S. date 9/24/99

Authorized by: Wesley Sparks R.S. date 5/11/99 Existing System Inspection by: date

HEALTH DEPT. COPY: WHITE OWNER COPY (FINAL): YELLOW OWNER COPY (INITIAL): PINK