IREDELL COUNTY HEALTH DEPARTMENT

STATESVILLE 704-878-5305 MOORESVILLE 704-664-5281

IMPROVEMENT PERMIT / AUTHORIZATION TO CONSTRUCT / OPERATION PERMIT / EXISTING SYSTEM INSPECTION

PERMIT# 7035 PIN# 4668636788 DATE 9/16/99

OWNER OR CONTRACTOR David & Freda Granat (Piedmont) Chadwl PHONE: Business 528-7120 Piedmont Home

ADDRESS 125 E. Ridge Ln. Mooresville, NC 28115

LOCATION Hwy 150 E TL Overhead bridge TR Oliphant TL Eastridge 3rd on left

SUBDIVISION Eastridge BLOCK / SECTION LOT 5 LOT AREA N1.21 Acre SITE CLASS. B DESIGN FLOW 360 L.T.A.R. 3

Septic Tank: 1000 Gallons; STB Date

Pump Tank: 1000 Gallons; PT Date

Pump Make: Model Serial No.

Nitrification Field: No. Fields 1 Square Feet 400' Linear Feet 200'

No. Lines 5 Trench Width 24" Max Trench Bottom Depth 30" Gravel Depth N/A

☒ New System ☐ Repair System Type: I, II, III, IV, V, VI

System Description: Pres-Panel-16" PBS

Repair System Description: Same

Maintenance Agreement Required: ☒ Yes ☒ No

☐ House/Mod. Home ☒ Mobile Home ☐ Business ☐ Other

No. Bedrooms 3 No. Bathrooms 2 No. Employees

☐ Slab ☒ Crawl Space ☐ Basement w/plumbing ☐ Basement wo/plumbing


Water Supply: ☒ Individual ☐ Public ☐ Community

Comments/Conditions: Existing System appears to be functioning okay at time of inspection, no problems noticed.


Comments/Conditions: 50% Reduction in Drainlines Changing 3 Bedroom SW for 3 Bedroom DW Home is same location

Not to Scale

INITIAL SITE SKETCH

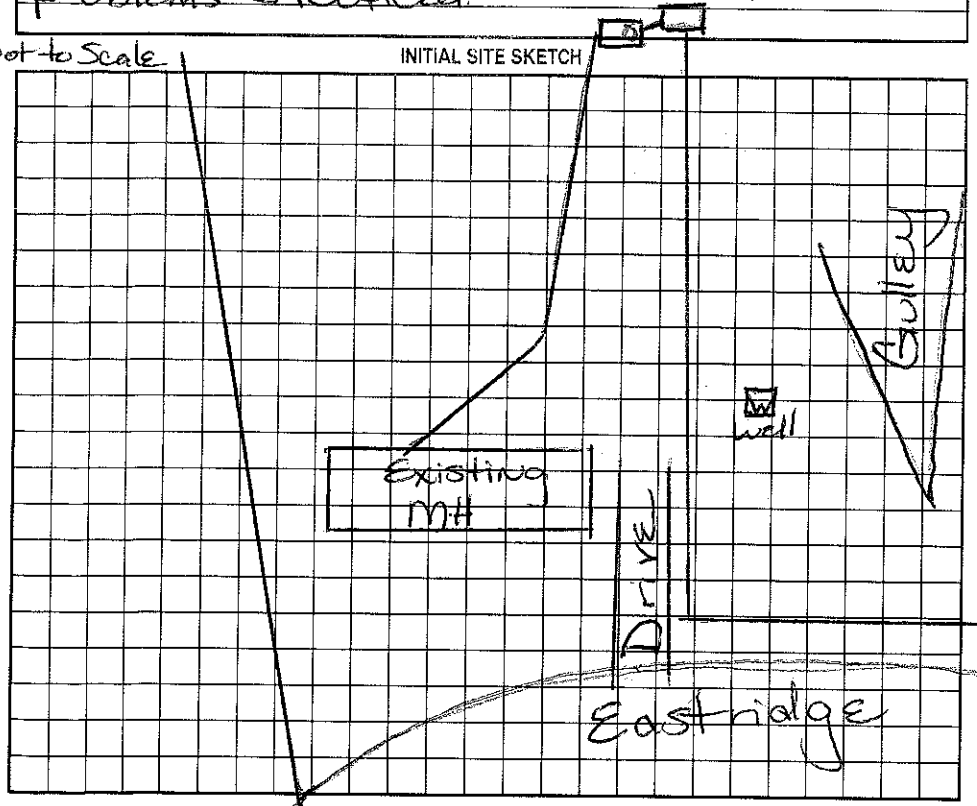

AS BUILT SKETCH

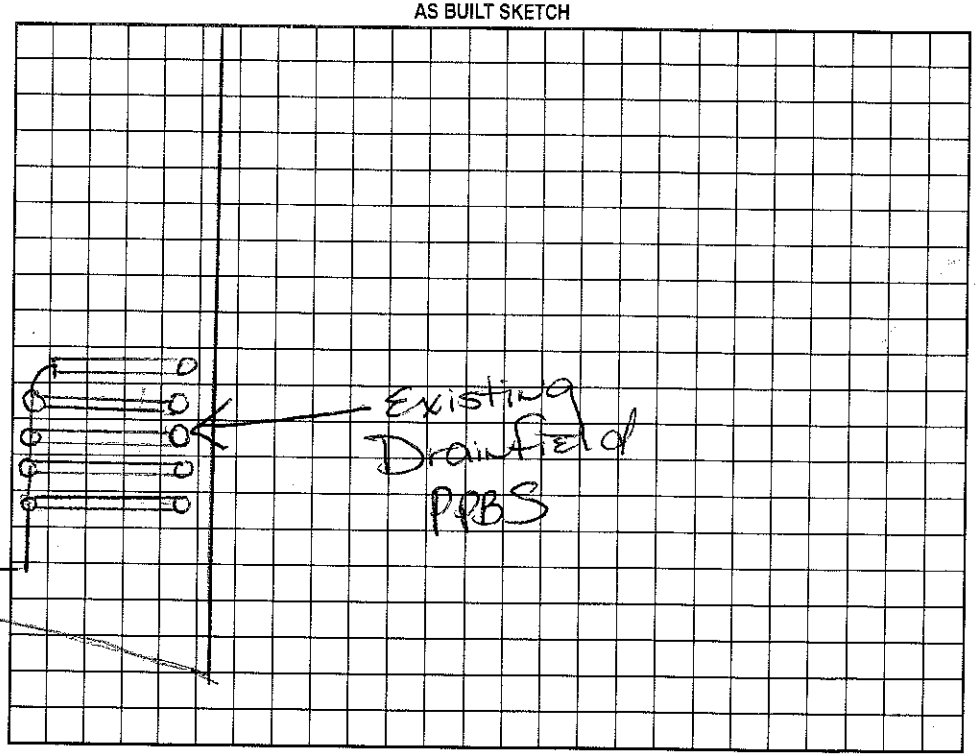

Permit can be suspended or revoked if any false information is supplied toward securing the permit/any unauthorized changes are made to the site/any unauthorized changes are made in the installation of the system. Improvement Permit with plat valid without expiration. Improvement Permit with site plan valid for sixty months. Authorization to Construct is valid for a period equal to that of Improvement Permit – not to exceed sixty months.

Signed: Chad R. Fox

Improvement Permit by: Maria H. Dolson RS date 9/16/99

Authorization to Construct by: date

Installed by:

Operation Permit by: date

Existing System Inspection by: Maria Dolson date 9/16/99

HEALTH DEPT. COPY: WHITE OWNER COPY (FINAL): YELLOW OWNER COPY (INITIAL): PINK

Inspections to Collect Fees.