IREDELL COUNTY HEALTH DEPARTMENT

Although plan call to Construct 4668636788

STATESVILLE 704-878-5305 MOORESVILLE 704-664-5281

IMPROVEMENT PERMIT / ~~CERTIFICATE OF COMPLETION~~ / OPERATION PERMIT / EXISTING SYSTEM INSPECTION

PROPERTY DESCRIPTION NO. 4601 DATE 5/8/97 TAX MAP NO. 1N1 C 5 Watershed: [X] Yes [ ] No

OWNER OR CONTRACTOR Freda Brandt PHONE: Business _____ Home 664-6970

ADDRESS 302 S Academy St. Mooresville, NC. 28115

LOCATION 5 Eastridge Rd; 150 E TL Overhead Bridge TR Elephant Rd. TL Eastridge Rd. 3rd site on (L)

SUBDIVISION Eastridge BLOCK / SECTION _____ LOT 5 LOT AREA ~1.21Ac SITE CLASS. PS DESIGN FLOW 360 L.T.A.R. .3

Septic Tank: 1000 Gallons; STB _____ Date _____

Pump Tank: 1000 Gallons; PT _____ Date _____

Pump Make: _____ Model _____ Serial No. _____

Nitrification Field: No Fields 1 Square Feet ~~X~~ 400 Linear Feet ~~X~~ 200

No Lines 5 Trench Width 24" Max Trench Bottom Depth 30" Gravel Depth STONE

[X] New System [ ] Repair System Type: I, II, III (IV) V, VI

System Description: PRES-PANEL-16"PPBS

Repair System Description: SAME

Maintenance Agreement Required: [X] Yes [ ] No

[ ] House/Mod. Home No. Bedrooms 3

[X] Mobile Home No. Bathrooms 2

[ ] Business No. Employees _____

[ ] Other _____


[ ] Slab [X] Crawl Space [ ] Basement w/plumbing [ ] Basement wo/plumbing

Water Supply: [X] Individual [ ] Community [ ] Public


Comments:

Comments:

INITIAL SITE SKETCH

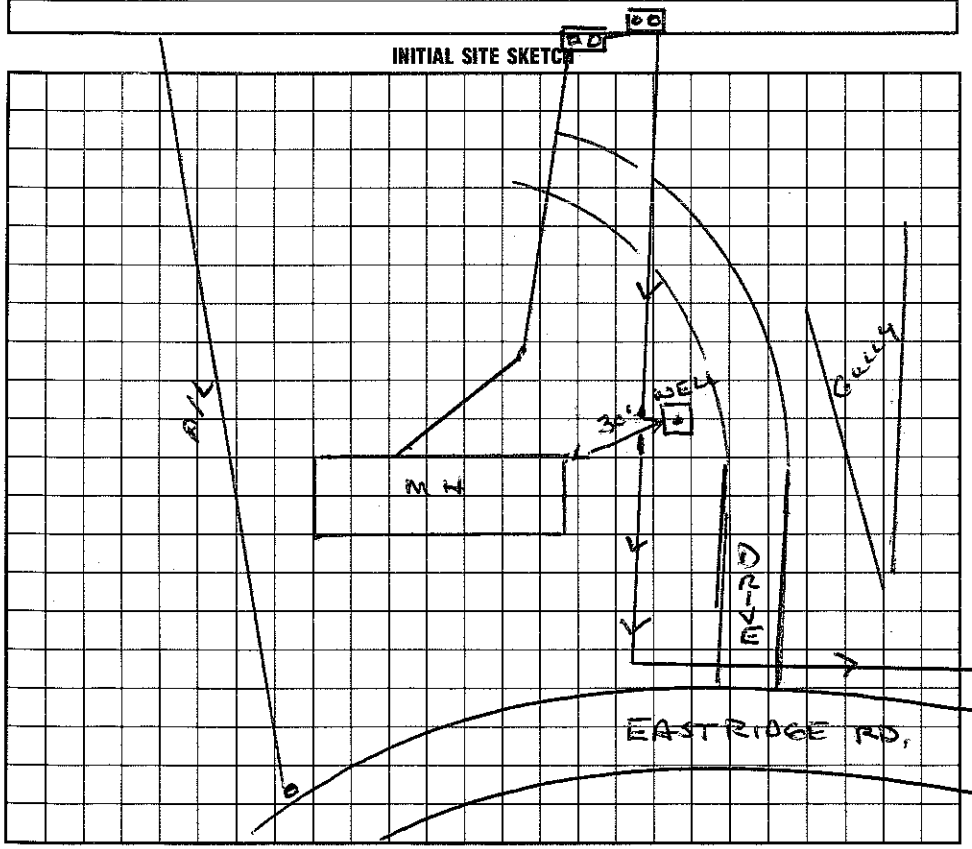

AS BUILT SKETCH

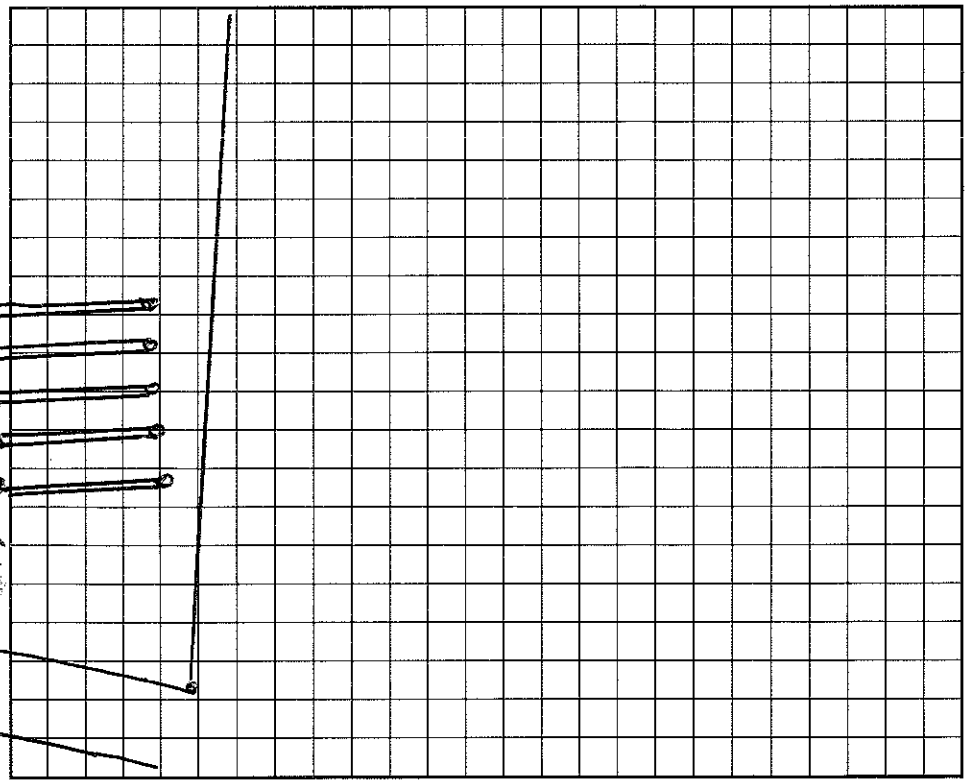

I understand that this permit can be suspended or revoked if any false information is supplied toward securing the permit/any unauthorized changes are made to the site/any unauthorized changes are made in the installation of the system. Improvement Permit is valid for 60 months from date of issuance.

Signed: _____ Installed by: Wayne Potts

Improvement Permit by: _____ date _____ Certificate of Completion by: Wesley Sparks RS. date 5/8/97

Existing System Inspection by: _____ date _____ Operation Permit by: Wesley Sparks RS. date 5/8/97

HEALTH DEPT. COPY: WHITE INSPECTION COPY (FINAL): GREEN OWNER COPY (FINAL): YELLOW INSPECTION COPY (INITIAL): PINK OWNER COPY (INITIAL): GOLD