IREDELL COUNTY HEALTH DEPARTMENT

STATESVILLE 704-878-5305 MOORESVILLE 704-664-5281

IMPROVEMENT PERMIT / CERTIFICATE OF COMPLETION / OPERATION PERMIT / EXISTING SYSTEM INSPECTION

PROPERTY DESCRIPTION NO. 3195 DATE 3/17/95 TAX MAP NO. IN1-C-19 Watershed: ☐ Yes ☒ ~~No~~

OWNER OR CONTRACTOR BOB CRUM PHONE: ~~Business~~ PIN# 4668-63-8512 Home 663-1768

ADDRESS 830 E Iredell Expy Mooresville, NC

LOCATION 150E, TL Overhead Bridge TR Elephant TL Eastridge to 4th lot on (R)

SUBDIVISION EASTRIDGE BLOCK / SECTION ____ LOT 19 LOT AREA ~24,200 SITE CLASS. P DESIGN FLOW 360 L.T.A.R. .3

Septic Tank: 1000 Gallons; STB 1012 Date 2/14/95

Pump Tank: ____ Gallons; PT ____ Date ____

Pump Make: ____ Model ____ Serial No. ____

Nitrification Field: No Fields 1 Square Feet 1200 Linear Feet ~~*~~ 210

No Lines 3 Trench Width 24" Max Trench Bottom Depth 28" Gravel Depth 6" SAND

☐ New System ☐ Repair System Type: I, II, (III) IV, V, VI

System Description: 16PPB5 - DIST BOX

Repair System Description: SAME

Maintenance Agreement Required: ☐ Yes ☒ No

☐ House/Mod. Home ☒ Mobile Home ☐ Business ☐ Other

No. Bedrooms 3 No. Bathrooms 2 No. Employees ____


☐ Slab ☒ Crawl Space ☐ Basement w/plumbing ☐ Basement wo/plumbing

Water Supply: ☒ Individual ☐ Community ☐ Public

Comments: * 210 linear ft. of 16" Precast. Panel Blocks

Comments:

INITIAL SITE SKETCH

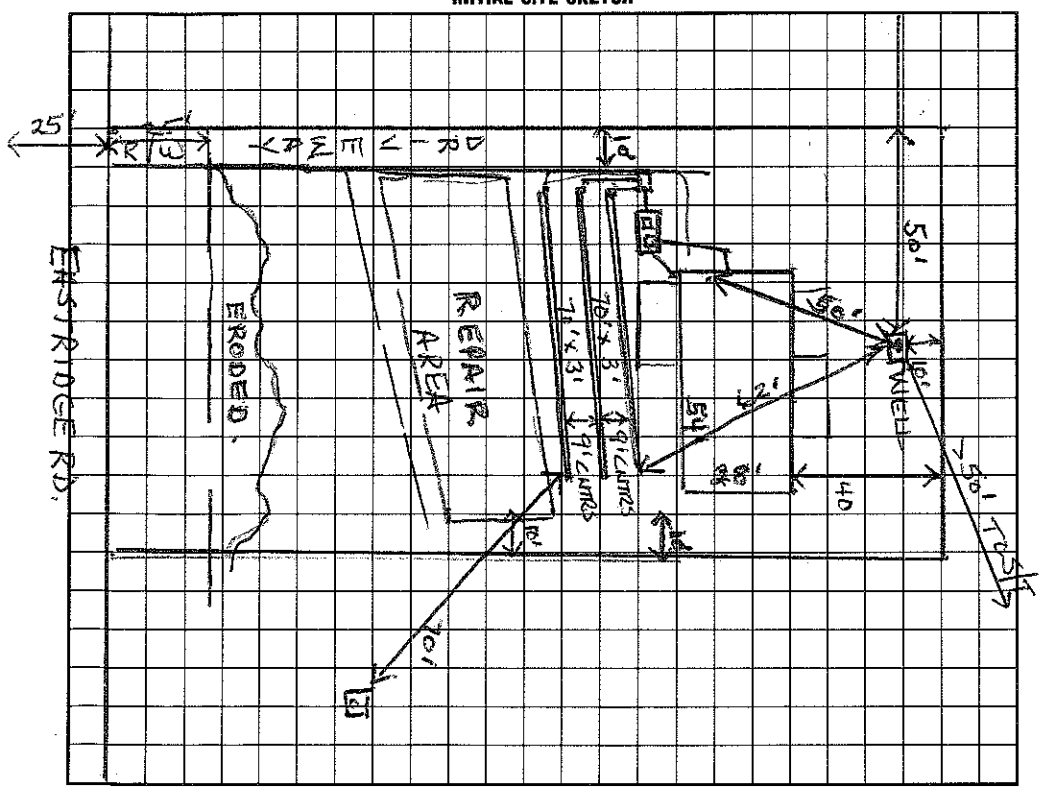

AS BUILT SKETCH

I understand that this permit can be suspended or revoked if any false information is supplied toward securing the permit/any unauthorized changes are made to the site/any unauthorized changes are made in the installation of the system. Improvement Permit is valid for 60 months from date of issuance.

Signed: Bobby Crum

Improvement Permit by: Wesley Sparks RS. date 3/17/95

Existing System Inspection by: ____ date ____

Installed by: Kenny Pearson

Certificate of Completion by: Wesley Sparks RS. date 4/28/95

Operation Permit by: ____ date ____

HEALTH DEPT. COPY: WHITE INSPECTION COPY (FINAL): GREEN OWNER COPY (FINAL): YELLOW INSPECTION COPY (INITIAL): PINK OWNER COPY (INITIAL): GOLD