3:30

IREDELL COUNTY HEALTH DEPARTMENT

STATESVILLE 704-878-5305 MOORESVILLE 704-664-5281

IMPROVEMENT PERMIT / AUTHORIZATION TO CONSTRUCT / OPERATION PERMIT / EXISTING SYSTEM INSPECTION

PERMIT # 154250 PIN # 4668-69-0213 DATE 2-9-09

OWNER or APPLICANT GARY LEE + RENDIE C. KOLSTAD PHONE: Business Home: 704-664-1533

OWNER or APPLICANT ADDRESS 127 WOODRIDGE LN MOORESVILLE NC 28115

LOCATION / DIRECTIONS ZIN, TR MAZZEPA RD, TL WOODRIDGE LN, 3RD ON L

SUBDIVISION WOODRIDGE BLOCK / SECTION LOT # 22 LOT AREA .91AC DESIGN FLOW 360 L.T.A.R. .35

Septic Tank 1000 Gallons: STB 794 Date 5-15-09

Pump Tank Gallons: P T Date

Pump Make Model Serial #

Nitrification Field No Fields 1 No Lines 4 Linear Feet 260'

Trench Width 36" Max. Trench Bottom Depth 36" Gravel Depth — GRAVITY PRESSURE

☒ New System ☐ Repair ☐ Expansion System Type I II III IV V VI

System Description: GRAVITY 25% REDUCTION

Repair System Description: LP- PANEL

Maintenance Agreement Required ☐ YES ☒ NO INITIALLY

☒ Residence No. Bedrooms 3

☐ Business No. Persons

☐ Other No. Employees

☐ Slab ☒ Crawl Space

☐ Basement w/plumbing ☐ Basement w/o plumbing


Water Supply ☒ Private SHARED ☐ Public ☐ Community

Comments / Conditions 1) SEPTIC TANK NEEDS TO BE BEHIND HOUSE TO GET GRAVITY FLOW 2) MAINTAIN ALL SETBACKS 3) SEPTIC MUST BE 100' FROM SHARED WELL


Comments / Conditions

Red Filter

INITIAL SITE SKETCH

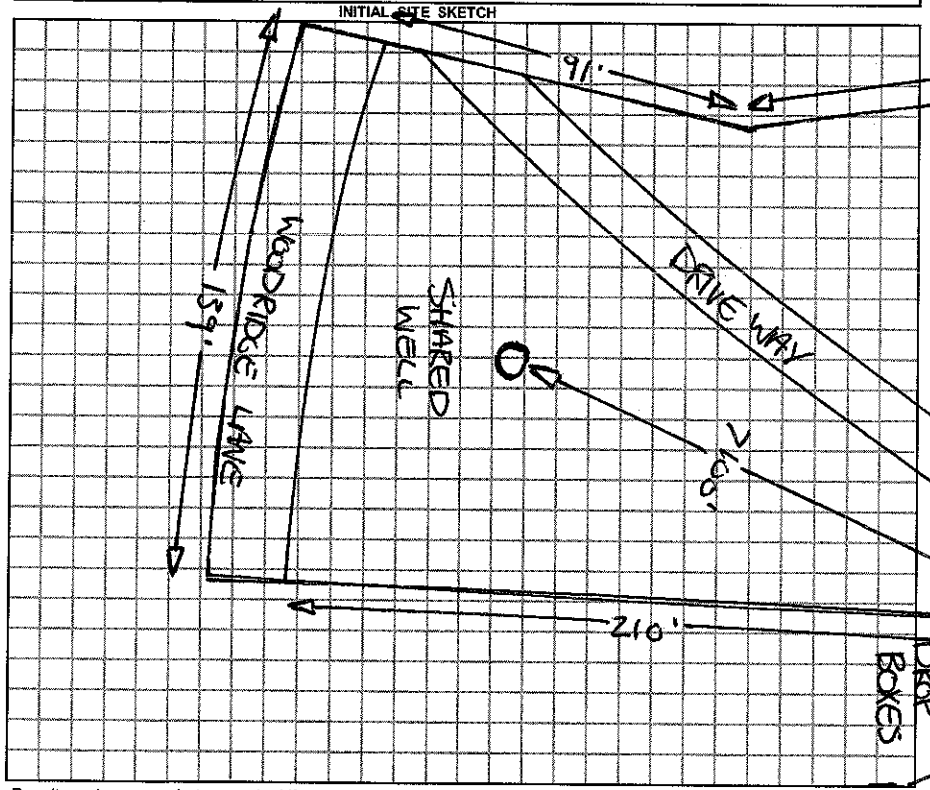

AS BUILT SKETCH

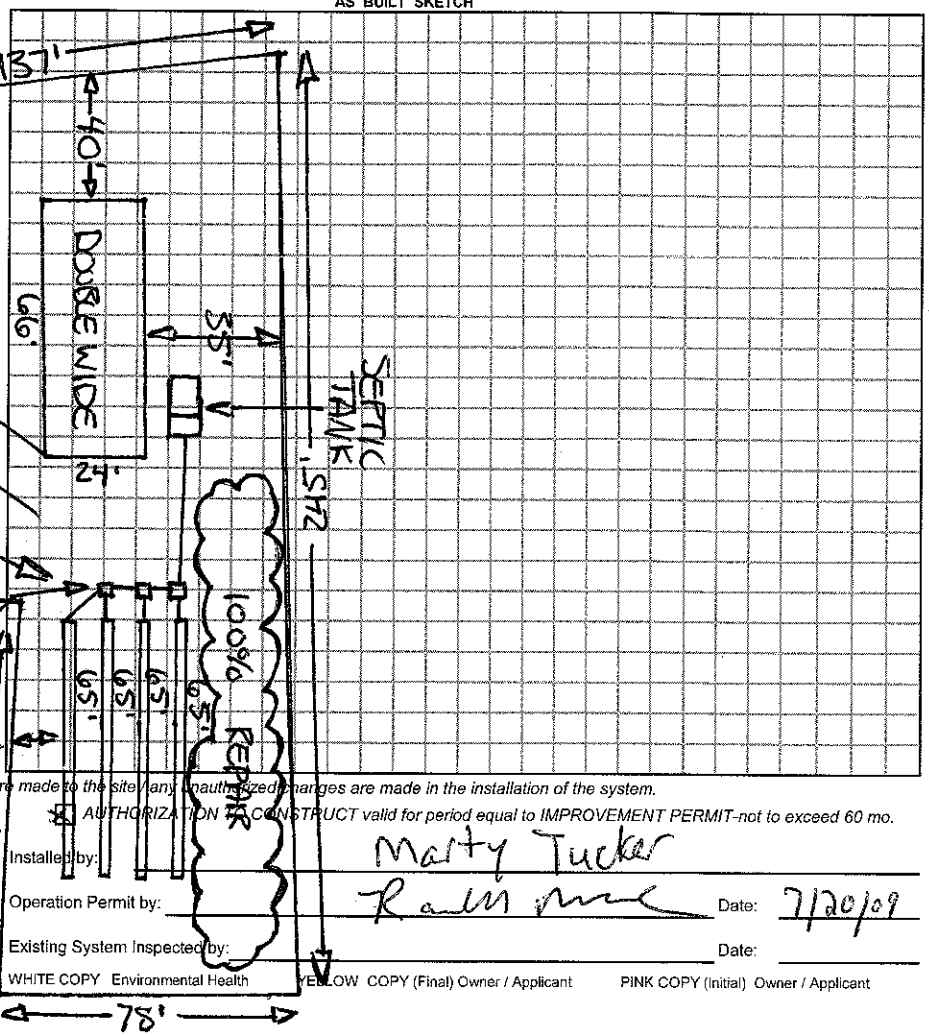

Permit can be suspended or revoked if any false information is supplied toward securing the permit / any unauthorized changes are made to the site / any unauthorized changes are made in the installation of the system.

☐ *IMPROVEMENT PERMIT w / plat valid without expiration.* ☒ *IMPROVEMENT PERMIT w / site plan valid for 60 mos.* ☒ *AUTHORIZATION TO CONSTRUCT valid for period equal to IMPROVEMENT PERMIT-not to exceed 60 mo.*

Owner / Applicant Signature: Date 2-10-09

Improvement Permit by: Date 2-9-09

Authorzation to Construct by: Date 2-9-09

YOU SHOULD CONTACT A LOCATOR SERVICE PRIOR TO ANY EXCAVATION.

Installed by: Marty Tucker

Operation Permit by: Date: 7/20/09

Existing System Inspected by: Date:

WHITE COPY Environmental Health YELLOW COPY (Final) Owner / Applicant PINK COPY (Initial) Owner / Applicant