IREDELL COUNTY HEALTH DEPARTMENT

STATESVILLE 704-878-5305 MOORESVILLE 704-664-

IMPROVEMENT PERMIT / AUTHORIZATION TO CONSTRUCT / OPERATION PERMIT / EXISTING SYSTEM ... PECTION

PERMIT# 087958 PIN# 4668 49 2367 DATE 3/3/00

OWNER OR CONTRACTOR Tracy Dodrum PHONE: Business 664-9381 Home

ADDRESS 204 Sprinkle Acres Dr. Mooresville, NC. 28115

LOCATION Mazeppa Rd. TL Woodridge Ln. to 3rd MH on (R)

SUBDIVISION Woodridge BLOCK / SECTION LOT 19 LOT AREA 1.0 SITE CLASS PS DESIGN FLOW 360 L.T.A.R.

Septic Tank: EXISTING Gallons; STB Date

Pump Tank: Gallons; PT Date

Pump Make: Model Serial No.

Nitrification Field: No Fields 1 Square Feet 704 Linear Feet 176

No Lines 2 Trench Width 8' Max Trench Bottom Depth 36" Gravel Depth 12"

☐ New System ☒ Repair System Type: I, II, (III) IV, V, VI

System Description:

Repair System Description: 88'X8' BED.

Maintenance Agreement Required: ☐ Yes ☒ No

☐ House/Mod. Home ☒ Mobile Home ☐ Business ☐ Other

No. Bedrooms 3 No. Bathrooms 2 No. Employees


Water Supply: ☒ Individual ☐ Public ☐ Community

☐ Slab ☒ Crawl Space ☐ Basement w/plumbing ☐ Basement wo/plumbing


Comments:/Conditions:

Comments:/Conditions: Infiltrator?

INITIAL SITE SKETCH

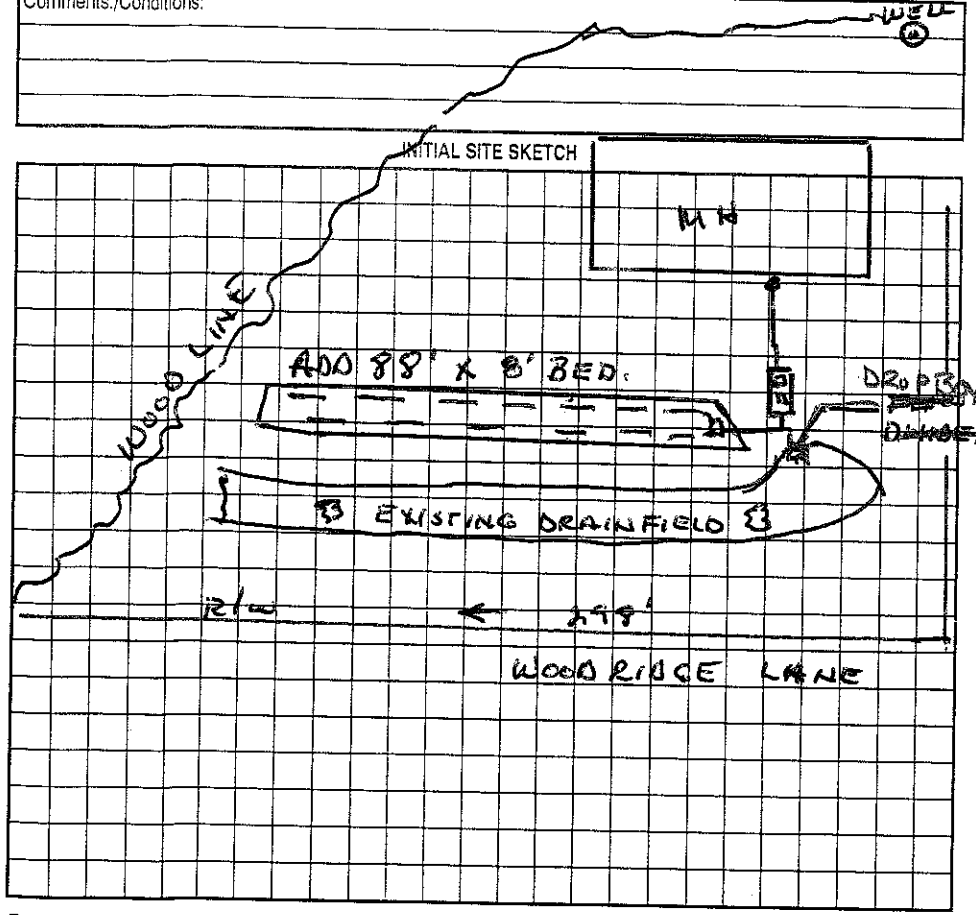

AS BUILT SKETCH

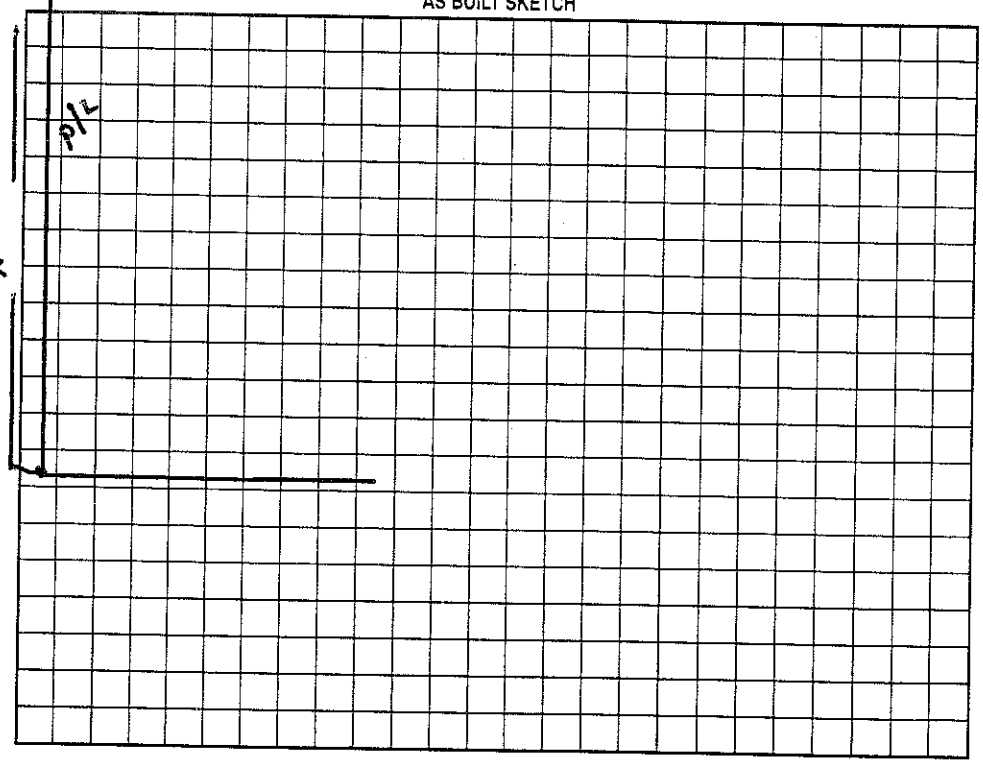

Permit can be suspended or revoked if any false information is supplied toward securing the permit/any unauthorized changes are made to the site/any unauthorized changes are made in the installation of the system. Improvement Permit with plat valid without expiration. Improvement Permit with site plan valid for sixty months. Authorization to Construct is valid for a period equal to that of Improvement Permit – not to exceed sixty months.

Signed: Tracy T. Godrum date 3/6/00

Improvement Permit by: Wesley Sparks RS. date 3/3/00

Authorization to Construct by: Wesley Sparks RS. date 3/3/00

Installed by: A-1 Backhoe

Operation Permit by: Maint. H2O Sparks RS date 3/7/2000

Existing System Inspection by: date

HEALTH DEPT. COPY: WHITE OWNER COPY (FINAL): YELLOW OWNER COPY (INITIAL): PINK