IREDELL COUNTY HEALTH DEPARTMENT

AUTHORIZATION TO CONSTRUCT

130

STATESVILLE 704-878-5305 MOORESVILLE 704-664-5281

IMPROVEMENT PERMIT / ~~CERTIFICATE OF COMPLETION~~ / OPERATION PERMIT / EXISTING SYSTEM INSPECTION

PROPERTY DESCRIPTION NO. 4594 DATE 4/25/97 TAX MAP NO. 4665 72 7685 75 Watershed: ☑ Yes ☐ No

OWNER OR CONTRACTOR PAUL WEBSTER PHONE: Business Home 669-6039

ADDRESS 632 OLIPHANT RD MOORESVILLE,

LOCATION 501 N- TL OLIPHANT RD - # 232 OLIPHANT RD ON LEFT

SUBDIVISION IN 4171 BLOCK / SECTION LOT 171 LOT AREA - SITE CLASS. PS DESIGN FLOW 360 GPD L.T.A.R. —

Septic Tank: EXISTING Gallons; STB Date

Pump Tank: Gallons; PT Date

Pump Make: Model Serial No.

Nitrification Field: No Fields 1 Square Feet 300 Linear Feet 100

No Lines 2 @ 50' Trench Width 36" Max Trench Bottom Depth 36" Gravel Depth 12"

☑ New System ☐ Repair System Type: I, II, III, IV, V, VI

System Description: GRAVITY CONVENTIONAL

Repair System Description: SAME

Maintenance Agreement Required: ☐ Yes ☑ No

☐ ~~House~~/Mod. Home No. Bedrooms 3

☐ Mobile Home No. Bathrooms 2

☐ Business No. Employees

☐ Other


☐ Slab ☑ Crawl Space ☐ Basement w/plumbing ☐ Basement wo/plumbing

Water Supply:
☑ ~~Individual~~
☐ Community
☐ Public


Comments:

Comments:

INITIAL SITE SKETCH NOT TO SCALE

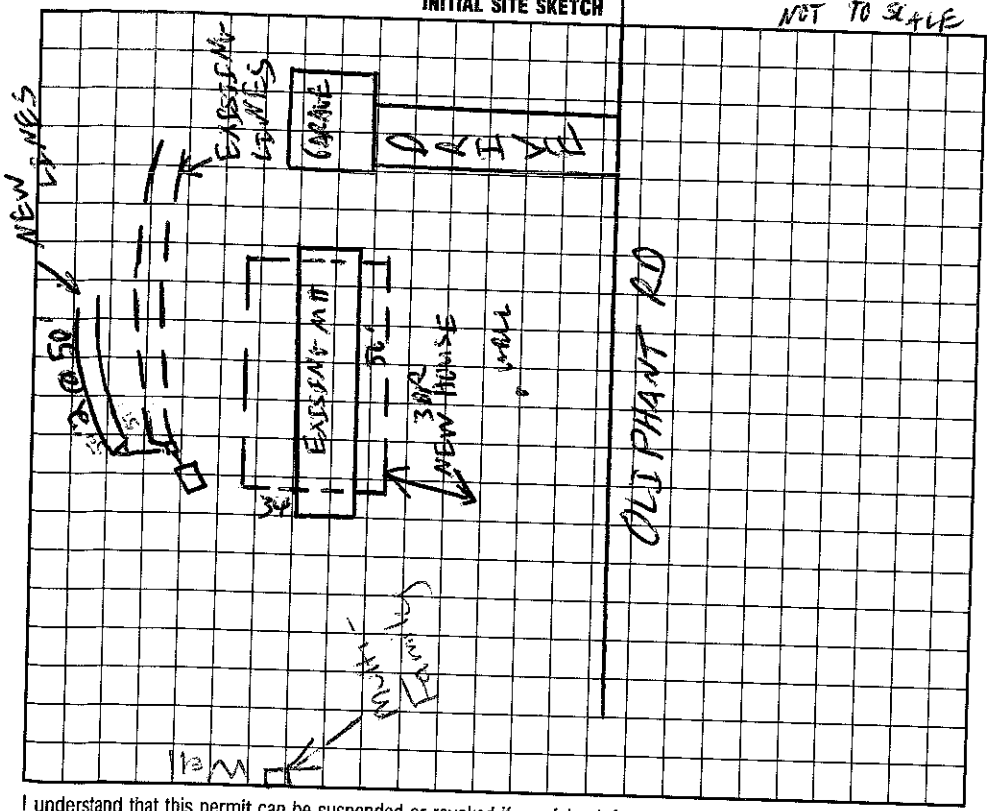

AS BUILT SKETCH

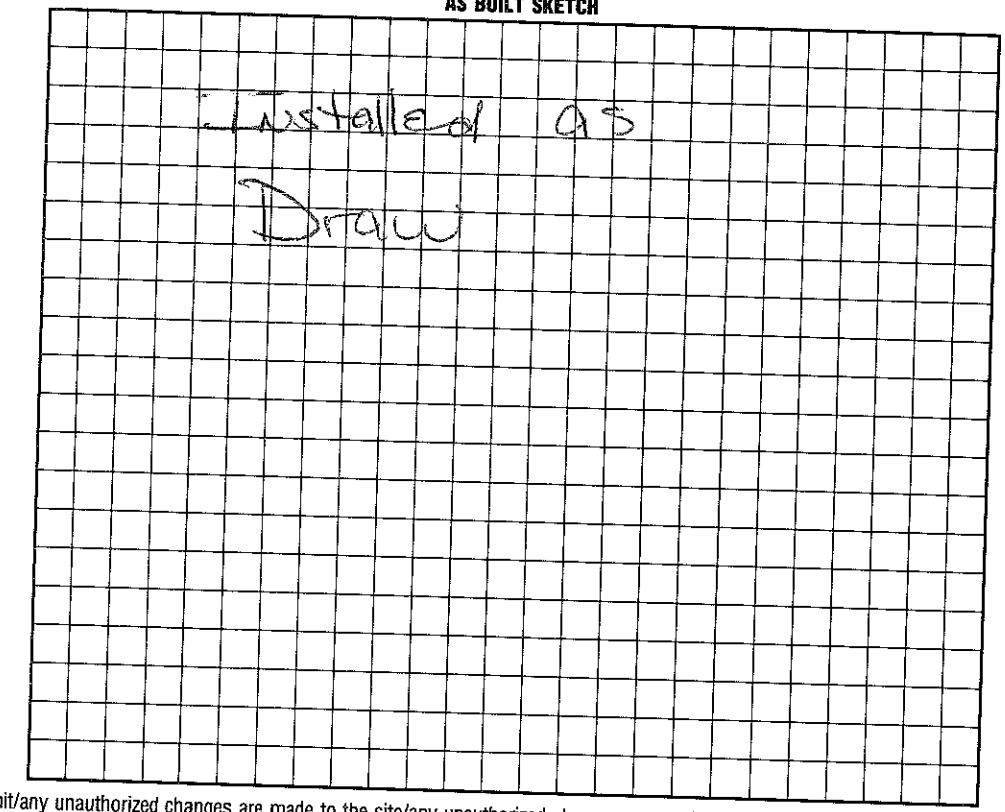

I understand that this permit can be suspended or revoked if any false information is supplied toward securing the permit/any unauthorized changes are made to the site/any unauthorized changes are made in the installation of the system. Improvement Permit is valid for 60 months from date of issuance.

Signed: Paul Webster

Improvement Permit by: [signature] date 4/25/97

~~Existing System Inspection by:~~ AUTHORIZATION TO CONSTRUCT [signature] date 4/25/97

Installed by: Tim Ammons

Certificate of Completion by: Marian H. Dotson date 6/5/97

Operation Permit by: Marian H. Dotson date 6/5/97

HEALTH DEPT. COPY: WHITE INSPECTION COPY (FINAL): GREEN OWNER COPY (FINAL): YELLOW INSPECTION COPY (INITIAL): PINK OWNER COPY (INITIAL): GOLD