4668733119

IREDELL COUNTY HEALTH DEPARTMENT

STATESVILLE 704-878-5305 MOORESVILLE 704-664-5281

IMPROVEMENT PERMIT / CERTIFICATE OF COMPLETION / OPERATION PERMIT / EXISTING SYSTEM INSPECTION

PROPERTY DESCRIPTION NO. 2950 DATE 9/16/94 TAX MAP NO. IN 1A 50 Watershed: ☑ Yes ☐ No

OWNER OR CONTRACTOR JAMES F. WILSON PHONE: Business _____ Home 663-1405

ADDRESS Rt 10 Box 165 Mooresville, NC. 28115

LOCATION 801 N. TL OLIPHANT RD., TO (R) OF 3RD BRICK HOUSE ON (R)

SUBDIVISION N/A BLOCK / SECTION _____ LOT 53+54 LOT AREA ~11000 FT² SITE CLASS. P DESIGN FLOW 240 L.T.A.R. .3

Septic Tank: 1000 Gallons; STB 794 Date 9/27/94
Pump Tank: _____ Gallons; PT _____ Date _____
Pump Make: _____ Model _____ Serial No. _____
Nitrification Field: No Fields 1 Square Feet 800 Linear Feet 133
No Lines 5 Trench Width 24" Max Trench Bottom Depth 30

☑ New System ☐ Repair System Type: I, II, (III) IV, V, VI
System Description: 16" PPBS
Repair System Description: PRES PPBS
Maintenance Agreement Required: ☐ Yes ☑ No

☐ House/Mod. Home No. Bedrooms 2
☑ Mobile Home No. Bathrooms 2
☐ Business No. Employees _____
☐ Other _____

Gravel Depth 6" SAND ☐ Slab ☑ Crawl Space ☐ Basement w/plumbing ☐ Basement wo/plumbing


Water Supply: ☑ Individual ☐ Community ☐ Public FATHER

Comments: Trailer located as shown, septam can't be installed properly.

Comments: S/T + TAP LINE - 11/9/94

installed as shown on Imp Permit

INITIAL SITE SKETCH

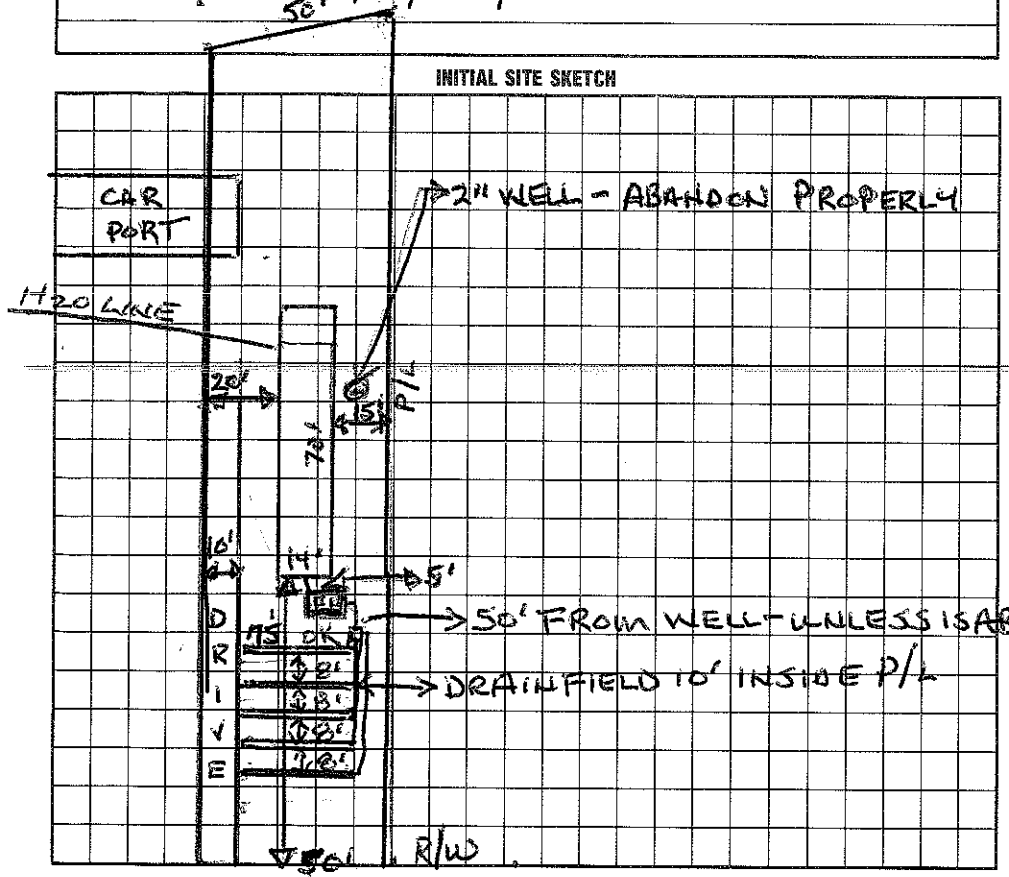

AS BUILT SKETCH

I understand that this permit can be suspended or revoked if any false information is supplied toward securing the permit/any unauthorized changes are made to the site/any unauthorized changes are made in the installation of the system. Improvement Permit is valid for 60 months from date of issuance.

Signed: J. Wilson

Improvement Permit by: Wesley Sparks RS. date 9/16/94

Existing System Inspection by: _____ date _____

Installed by: F J Evans

Certificate of Completion by: Wesley Sparks RS date 11/14/94

Operation Permit by: _____ date _____

HEALTH DEPT. COPY: WHITE INSPECTION COPY (FINAL): GREEN OWNER COPY (FINAL): YELLOW INSPECTION COPY (INITIAL): PINK OWNER COPY (INITIAL): GOLD