-11:30-

IREDELL COUNTY HEALTH DEPARTMENT

Statesville Office (704) 878-5305 Mooresville Office (704) 660-3625 PERMIT #

IMPROVEMENT PERMIT / AUTHORIZATION TO CONSTRUCT / OPERATION PERMIT / EXISTING SYSTEM

PIN # 4668734195

APPLICANT: Florence Kistler APPLICANT ADDRESS: 211 Oliphant Rd. Mooresville

SITE ADDRESS: 211 Oliphant RD. Mooresville PHONE: 704663-4864 ALT. PHONE:

SITE DIRECTIONS: From Mooresville, 801 North TL Oliphant Rd ~¼ mile on Right

SUBDIVISION: SECTION: LOT # LOT AREA: ~1½ Ac DESIGN FLOW: 240gpd L.T.A.R.: .3

Septic Tank Existing (gal) STB Date
Pump Tank (gal) PT Date
Pump Make Model Serial #
Nitrification Fields 1 # Lines 4 Linear Ft: 200
Trench Width 36" Max. Trench Bottom Depth 36" Gravel Depth NA


☐ New System ☒ Repair ☐ Expansion System Type: I II (III) IV V VI
System Description:
Repair System Description: 25% Reduction
Maintenance Agreement Required: ☐ YES ☒ NO
☒ GRAVITY ☐ PRESSURE

☒ Residence No. Bedrooms 2
☐ Business No. Persons
☐ Other No. Employees
☐ Slab ☒ Crawl Space
☐ Basement w/plumbing ☐ Basement w/o plumbing

Water Supply
☐ Private
☐ Public
☐ Community

Comments / Conditions:

INITIAL SITE SKETCH

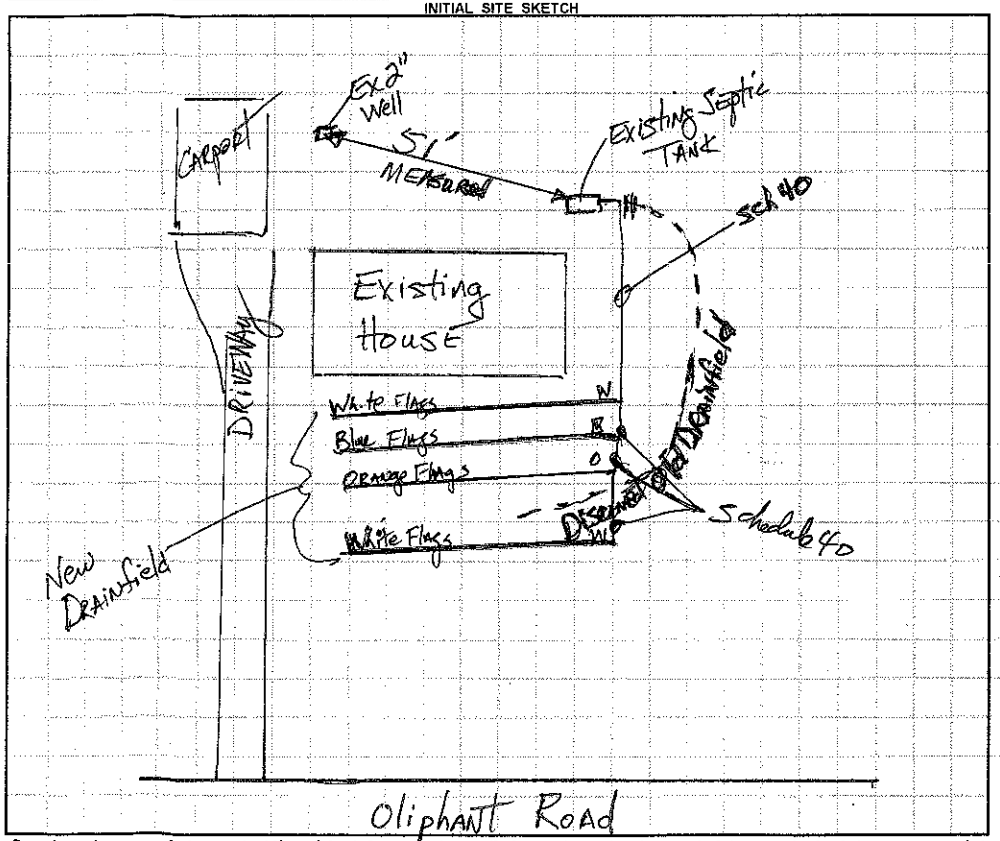

AS BUILT SKETCH

Installed as shown

Permit can be suspended or revoked if any false information is supplied toward securing the permit / any unauthorized changes are made to the site / any unauthorized changes are made in the installation of the system. **CONTACT A LOCATOR SERVICE PRIOR TO ANY EXCAVATION**

☐ **IMPROVEMENT PERMIT** *with plat valid without expiration.* ☒ **IMPROVEMENT PERMIT** *with site plan valid for 60 mos.* ☐ **AUTHORIZATION TO CONSTRUCT** *valid for period equal to IMPROVEMENT PERMIT--not to exceed 60 mo.*

Owner / Applicant Signature: Rolins Kistler Date: Installed by: A1 BACKHOE

IMPROVEMENT PERMIT by: Parker R. Hinson, REHS Date: 5-13-13 OPERATION PERMIT by: Date: 5/15/13

AUTHORIZATION TO CONSTRUCT by: Parker R. Hinson, REHS Date: 5-13-13 Existing System Inspected by: Date:

Health Dept. Copy - WHITE Applicant (Final Approval) - YELLOW Applicant (Conditional Approval) - PINK