COPY

IREDELL COUNTY HEALTH DEPARTMENT

STATESVILLE 704-878-5305 MOORESVILLE 704-664-5281

IMPROVEMENT PERMIT / AUTHORIZATION TO CONSTRUCT / OPERATION PERMIT / EXISTING SYSTEM INSPECTION

PERMIT # REPAIR PIN # 4668-83-8305 DATE 3-24-11

OWNER or APPLICANT MAE BIRCHER PHONE: Business 704-663-0550 Home:

OWNER or APPLICANT ADDRESS 1036 MOUNT ULLA HWY

LOCATION / DIRECTIONS

SUBDIVISION BLOCK / SECTION LOT # LOT AREA 3/4 AC DESIGN FLOW 360 L.T.A.R.

Septic Tank 1000 Gallons: STB 760 Date 10-18

Pump Tank Gallons: P T Date

Pump Make Model Serial #

Nitrification Field No Fields No Lines Linear Feet

Trench Width Max Trench Bottom Depth 24" Gravel Depth

☐ New System ☒ Repair ☐ Expansion System Type I II III IV V VI

System Description: REPLACE TANK

Repair System Description:

Maintenance Agreement Required ☐ YES ☒ NO

☒ GRAVITY ☐ PRESSURE

☒ Residence No. Bedrooms 3 ☐ Business No. Persons ☐ Other No. Employees


☐ Slab ☒ Crawl Space ☐ Basement w/plumbing ☐ Basement w/o plumbing

Water Supply: ☒ Private ☐ Public ☐ Community


Comments / Conditions

Comments / Conditions ① MEET STATE RULES ② PUMP, CRUSH & FILL OLD TANK

INITIAL SITE SKETCH

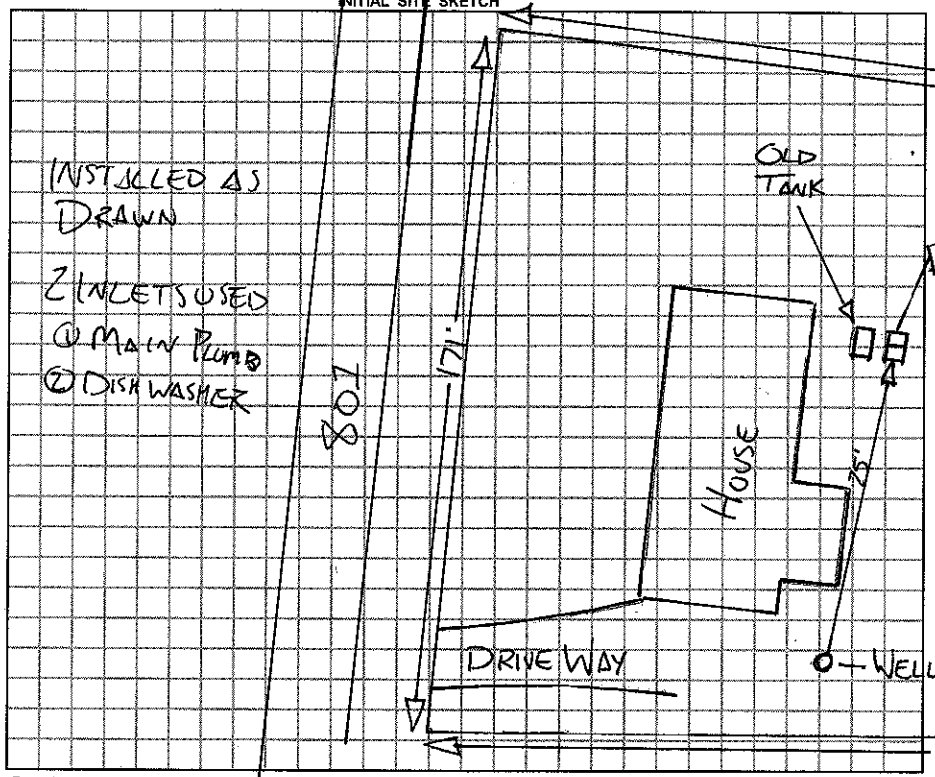

AS BUILT SKETCH

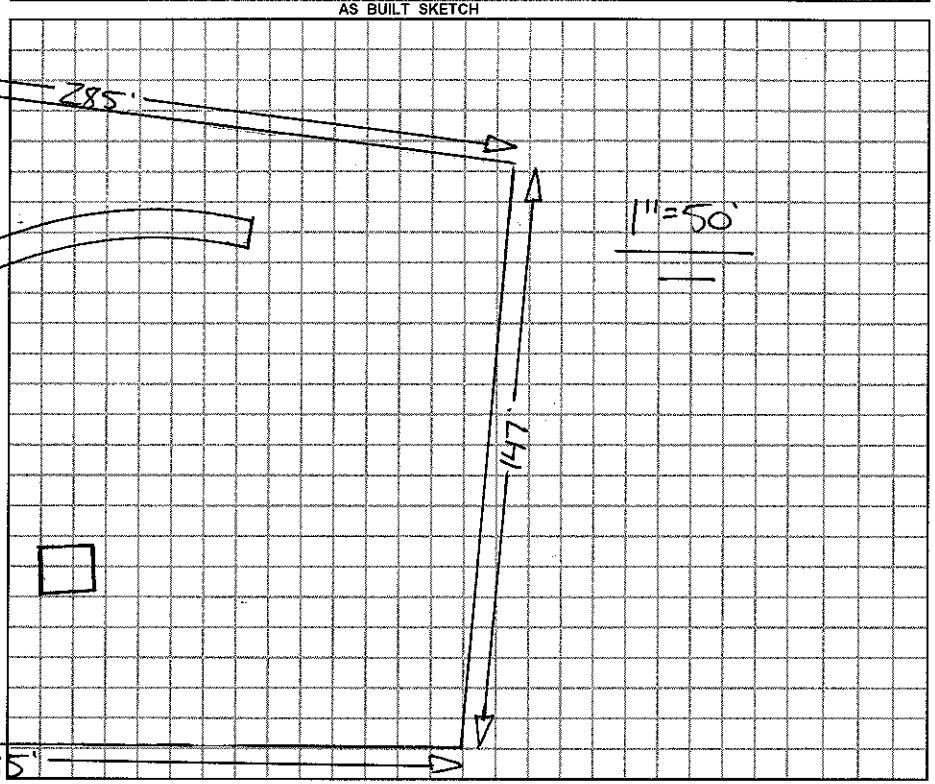

Permit can be suspended or revoked if any false information is supplied toward securing the permit / any unauthorized changes are made to the site / any unauthorized changes are made in the installation of the system.

☐ *IMPROVEMENT PERMIT w / plat valid without expiration.* ☐ *IMPROVEMENT PERMIT w / site plan valid for 60 mos.* ☐ *AUTHORIZATION TO CONSTRUCT valid for period equal to IMPROVEMENT PERMIT-not to exceed 60 mo.*

Owner / Applicant Signature: Mae Bircher Date 3-24-11

Improvement Permit by: R.A. REHS Date 3-24-11

Authorization to Construct by: R.A. REHS Date 3-24-11

Installed by:

Operation Permit by: R.A. REHS Date: 3-25-11

Existing System Inspected by: Date:

YOU SHOULD CONTACT A LOCATOR SERVICE PRIOR TO ANY EXCAVATION.

WHITE COPY Environmental Health YELLOW COPY (Final) Owner / Applicant PINK COPY (Initial) Owner / Applicant