IREDELL COUNTY HEALTH DEPARTMENT

STATESVILLE 704-878-5305 MOORESVILLE 704-664-5281

IMPROVEMENT PERMIT / AUTHORIZATION TO CONSTRUCT / OPERATION PERMIT / EXISTING SYSTEM INSPECTION

138.00 Paid 2106

PERMIT# 127445 PIN# 4668911661 DATE 4-13-05

OWNER OR CONTRACTOR Richard Butler PHONE: Business _____ Home _____

ADDRESS 149 Jenny Marie Mooresville, NC 28115

LOCATION Hwy 150 East TL Hwy 801 (Mt. Ulla Hwy) TR Sardis Rd at end on right

SUBDIVISION Beverly Park BLOCK/SECTION A LOT 54 LOT AREA .60 Acre SITE CLASS PS DESIGN FLOW 240gpd L.T.A.R. .25

Septic Tank: 1000 Gallons; STB 1007 Date 2-1-06
Pump Tank: _____ Gallons; PT _____ Date _____
Pump Make: _____ Model _____ Serial No. _____
Nitrification Field: No Fields 1 Square Feet 720' Linear Feet 240'
No Lines 6@40 Trench Width 36" Max Trench Bottom Depth (24"-30") Gravel Depth N/A

☒ New System ☐ Repair System Type: I (II) III, IV, V, VI
System Description: Gravity - 25% Reduction
Repair System Description: Gravity - 50% Reduction
Maintenance Agreement Required: ☐ Yes ☒ No

☒ House/Mod. Home No. Bedrooms 3+
☐ Mobile Home No. Bathrooms 2
☐ Business No. Employees _____
☐ Other _____
☐ Slab ☒ Crawl Space ☐ Basement w/plumbing ☐ Basement wo/plumbing


Water Supply: ☒ Individual ☐ Public ☐ Community

Comments/Conditions: Keep Drainlines 10' from PL & 50' to well. Install lines shallow <30".

Comments/Conditions: Note: Okay to install 5 lines @ 48' each if it will fit.

Type 2

Scale 1:50 INITIAL SITE SKETCH

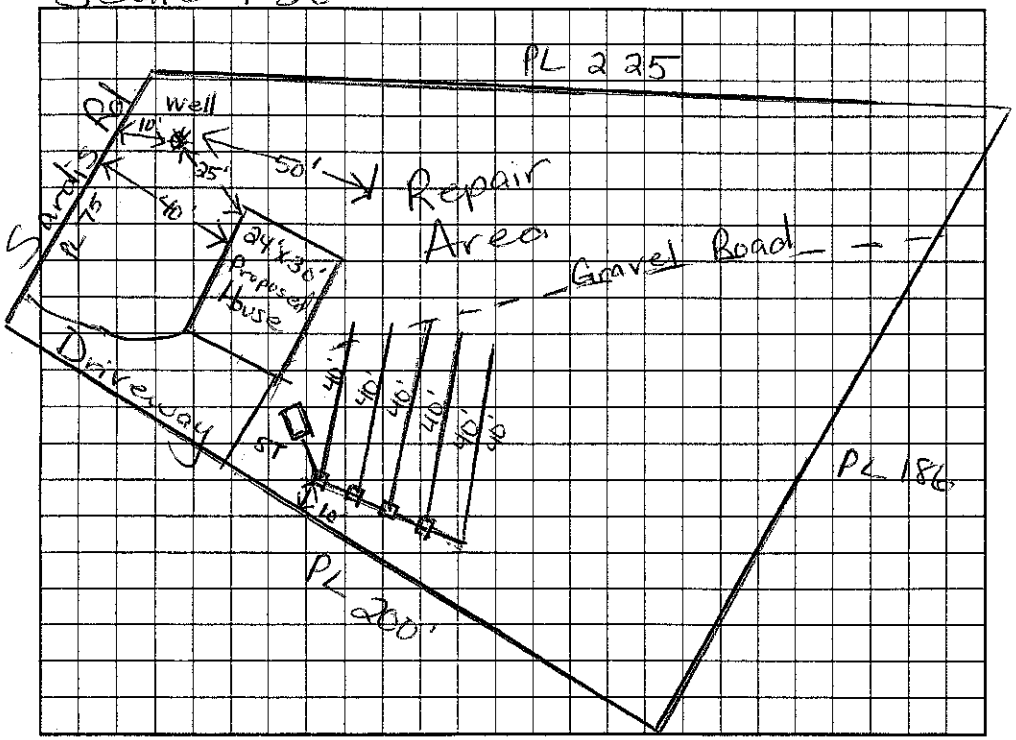

AS BUILT SKETCH

Installed essentially as Drawn

Used Quick 4

Permit can be suspended or revoked if any false information is supplied toward securing the permit/any unauthorized changes are made to the site/any unauthorized changes are made in the installation of the system. Improvement Permit with plat valid without expiration. Improvement Permit with site plan valid for sixty months. Authorization to Construct is valid for a period equal to that of Improvement Permit – not to exceed sixty months.

Signed: Richard Butler date 4-19-05 Installed by: Wayne Glantz Danie's Grading

Improvement Permit by: Maria H. Dotson RS date 4/13/05 Operation Permit by: Maria H. Dotson RS date 3/29/06

Authorization to Construct by: Maria H. Dotson RS date 4/13/05 Existing System Inspection by: _____ date _____

HEALTH DEPT. COPY: WHITE OWNER COPY (FINAL): YELLOW OWNER COPY (INITIAL): PINK