# IREDELL COUNTY HEALTH DEPARTMENT

4668925546

STATESVILLE 704-878-5305 MOORESVILLE 704-664-5281

## IMPROVEMENT PERMIT / CERTIFICATE OF COMPLETION / OPERATION PERMIT / EXISTING SYSTEM INSPECTION

PROPERTY DESCRIPTION NO. 5195 DATE 11-17-97 TAX MAP NO. 4668925546 Watershed: ☐ Yes ☐ No

OWNER OR CONTRACTOR Michael Mills PHONE: Business 664-7406 Home 664-7556

ADDRESS 238 Pepaw Dr. Mooresville, NC 28115

LOCATION Hwy 150 E 1/2 Mile past Hwy 801 turn left on Pepaw ~ 1/2 mile back in the woods

SUBDIVISION N/A BLOCK / SECTION N/A LOT N/A LOT AREA 5.79 Acres SITE CLASS. Exist DESIGN FLOW 360 gpd L.T.A.R.

Septic Tank: 1000 Gallons; STB Date

Pump Tank: Gallons; PT Date

Pump Make: Model Serial No.

Nitrification Field: No Fields 1 Square Feet Linear Feet

No Lines 3 at 115' Trench Width Exist Max Trench Bottom Depth Syst

☐ New System ☐ Repair System Type: I, II, III, IV, V, VI

System Description: Existing Syst

Repair System Description:

Maintenance Agreement Required: ☐ Yes ☐ No

☐ House/Mod. Home No. Bedrooms 3

☒ Mobile Home No. Bathrooms

☐ Business No. Employees

☐ Other


Gravel Depth ☐ Slab ☒ Crawl Space ☐ Basement w/plumbing ☐ Basement wo/plumbing

Water Supply: ☒ Individual ☐ Community ☐ Public

Comments: Changing M.H from 2 Bdrm to 3 Bdrm but Original System was designed for 3 Bdrm. Last 8/12/87 Michael Orig. permit Mills

Comments: Septic System appears to be functioning okay at time of inspection. No problems noted/visible. * Install cleanout on new line 50-75' from house.

### INITIAL SITE SKETCH

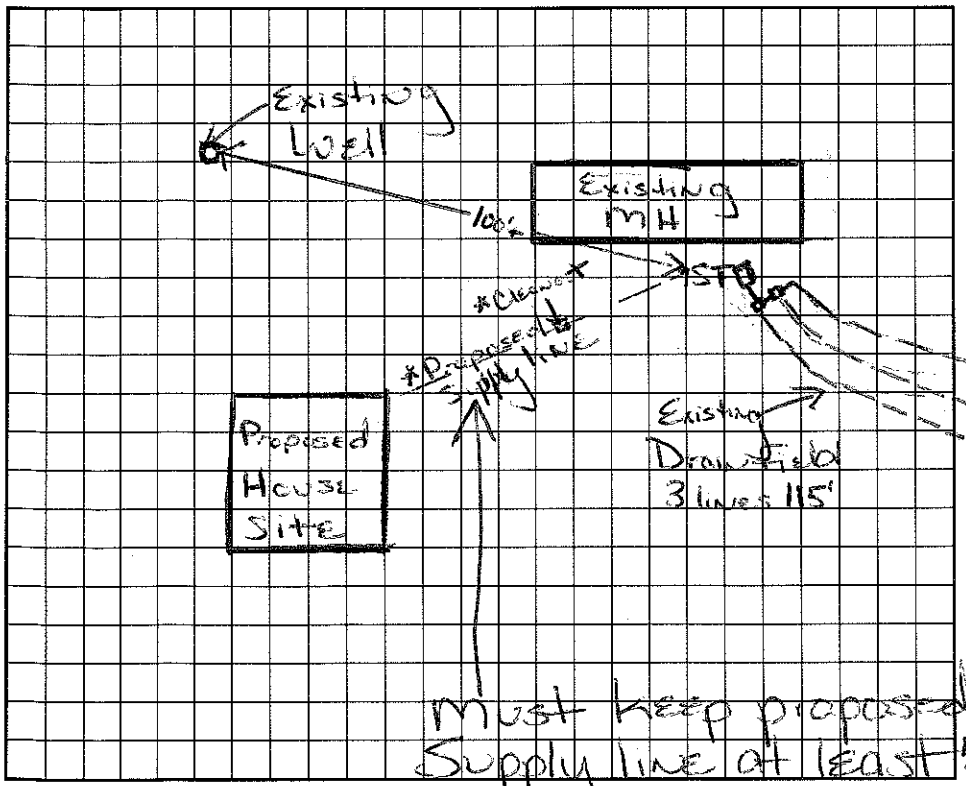


### AS BUILT SKETCH

I understand that this permit can be suspended or revoked if any false information is supplied toward securing the permit/any unauthorized changes are made to the site/any unauthorized changes are made in the installation of the system. Improvement Permit is valid for 60 months from date of issuance.

Signed: X

Improvement Permit by: Maria H. Hodgson date 11/17/97

Existing System Inspection by: Maria H. Hodgson date 11/17/97

Installed by:

Certificate of Completion by: date

Operation Permit by: date

HEALTH DEPT. COPY: WHITE INSPECTION COPY (FINAL): GREEN OWNER COPY (FINAL): YELLOW INSPECTION COPY (INITIAL): PINK OWNER COPY (INITIAL): GOLD