IREDELL COUNTY HEALTH DEPARTMENT

AUTHORIZATION TO CONSTRUCT

STATESVILLE 704-878-5305 MOORESVILLE 704-664-5281

IMPROVEMENT PERMIT / ~~CERTIFICATE OF COMPLETION~~ / OPERATION PERMIT / EXISTING SYSTEM INSPECTION

PROPERTY DESCRIPTION NO. 066952 DATE 5/28/97 TAX MAP NO. 4668931712 Watershed: ☑ Yes ☐ No

OWNER OR CONTRACTOR KATHY WAUGH PHONE: Business Home 664-9736

ADDRESS 1062 MT ULLA HWY. MOORESVILLE

LOCATION 501 N - # 1062 ON BOX. ON ~~RIGHT~~ RIGHT PAST OLIPHANT RD.

SUBDIVISION — BLOCK / SECTION — LOT — LOT AREA 1.65AC SITE CLASS. PS DESIGN FLOW ~~300~~ ≈100GPD L.T.A.R. .36AC/FT2

Septic Tank: 1000 Gallons; STB 16 IN Date 4/22/97

Pump Tank: ____ Gallons; PT ____ Date ____

Pump Make: ____ Model ____ Serial No. ____

Nitrification Field: No Fields 1 Square Feet 450 Linear Feet 150

No Lines 2@75' Trench Width 36" Max Trench Bottom Depth 36" Gravel Depth 12"

☑ New System ☐ Repair System Type: I, (II), III, IV, V, VI

System Description: GRAVITY CONVENTIONAL

Repair System Description: SAME

Maintenance Agreement Required: ☐ Yes ☑ No

☐ Slab ☑ Crawl Space ☐ Basement w/plumbing ☐ Basement wo/plumbing

☑ House/Mod. Home No. Bedrooms ____

☐ Mobile Home No. Bathrooms 1

☑ Business No. Employees 1


☐ Other 1 CHAIR BARBER SHOP

Water Supply:
☑ Individual
☐ Community
☐ Public


Comments: KEEP SYSTEM 50' FROM EXISTING WELL.

Comments:

INITIAL SITE SKETCH 1" = 60'

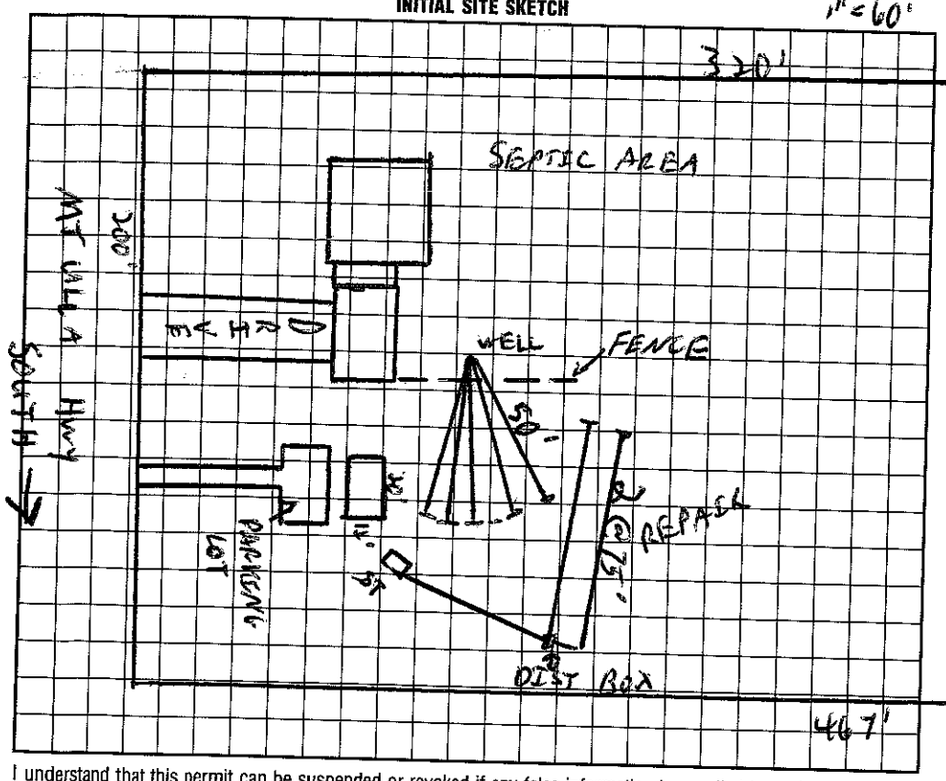

AS BUILT SKETCH

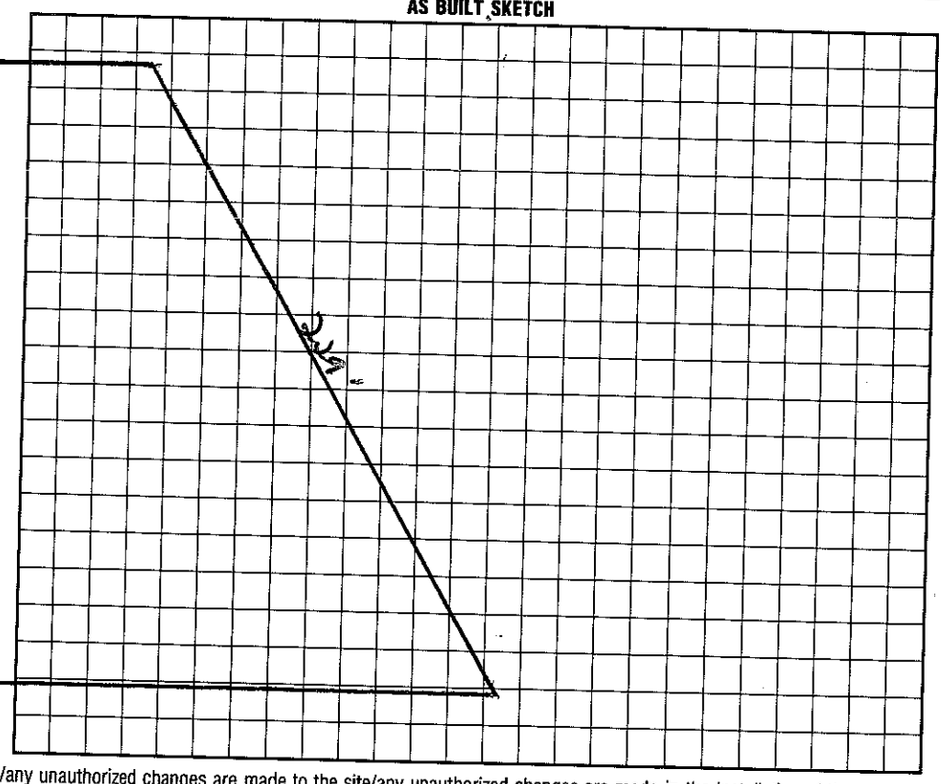

I understand that this permit can be suspended or revoked if any false information is supplied toward securing the permit/any unauthorized changes are made to the site/any unauthorized changes are made in the installation of the system. Improvement Permit is valid for 60 months from date of issuance.

Signed: Kathy Waugh

Improvement Permit by: [signature] BWST date 5/28/97

~~Existing System Inspection by:~~ ANOTHER PATTERN CONSTRUCTION [signature] BWST date 5/28/97

Installed by: JC Forsyth

Certificate of Completion by: Wesley Sparks RS. date 6/17/97

Operation Permit by: Wesley Sparks RS. date 6/17/97

HEALTH DEPT. COPY: WHITE INSPECTION COPY (FINAL): GREEN OWNER COPY (FINAL): YELLOW INSPECTION COPY (INITIAL): PINK OWNER COPY (INITIAL): GOLD