4668942505

IREDELL COUNTY HEALTH DEPARTMENT

STATESVILLE 704-878-5305 MOORESVILLE 704-664-5281

IMPROVEMENT PERMIT / CERTIFICATE OF COMPLETION / OPERATION PERMIT / EXISTING SYSTEM INSPECTION

PROPERTY DESCRIPTION NO. REPAIR DATE 10/23/96 TAX MAP NO. REPAIR Watershed: ☐ Yes ☐ No

OWNER OR CONTRACTOR CARL A BROWN PHONE: Business Home 663-4941

ADDRESS 1095 MT ULLA HWY - MOORESVILLE NC 28115

LOCATION 8015 on Left ACROSS FROM JULIETT DR - #1095 #

SUBDIVISION — BLOCK / SECTION — LOT — LOT AREA — SITE CLASS. PS DESIGN FLOW — L.T.A.R. —

Septic Tank: EXISTING Gallons; STB Date

Pump Tank: Gallons; PT Date

Pump Make: Model Serial No.

Nitrification Field: No Fields Square Feet 370 Linear Feet 190

No Lines 3 Trench Width 36" Max Trench Bottom Depth AS NEEDED Gravel Depth 12"

☑ New System ☐ Repair System Type: I, II, III, IV, V, VI

System Description: GRAVITY CONV.

Repair System Description:

Maintenance Agreement Required: ☐ Yes ☑ No

☑ House/Mod. Home ☐ Mobile Home ☐ Business ☐ Other

No. Bedrooms 3 No. Bathrooms 2.5 No. Employees


☑ Slab ☑ Crawl Space ☐ Basement w/plumbing ☐ Basement wo/plumbing

Water Supply: ☑ Individual ☐ Community ☐ Public


Comments: TANK MAY NEED REPLACING, PUMPED. OR SANITARY TEE FIXED.

Comments: Changed TYPE III

INITIAL SITE SKETCH

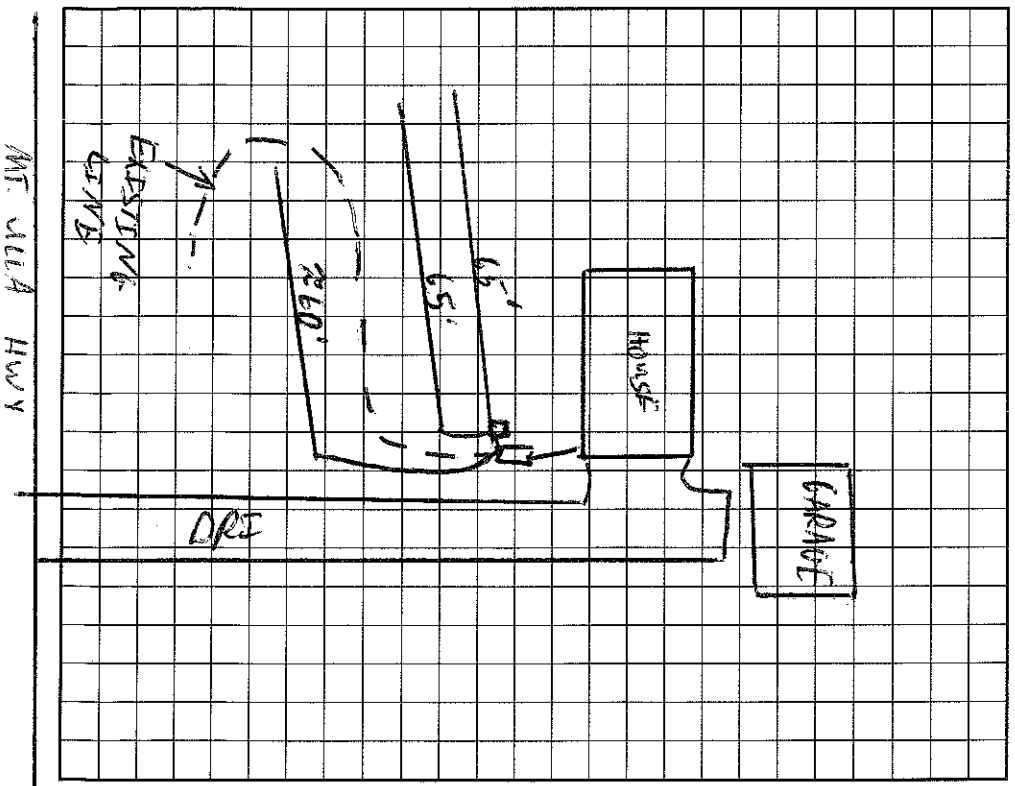

AS BUILT SKETCH

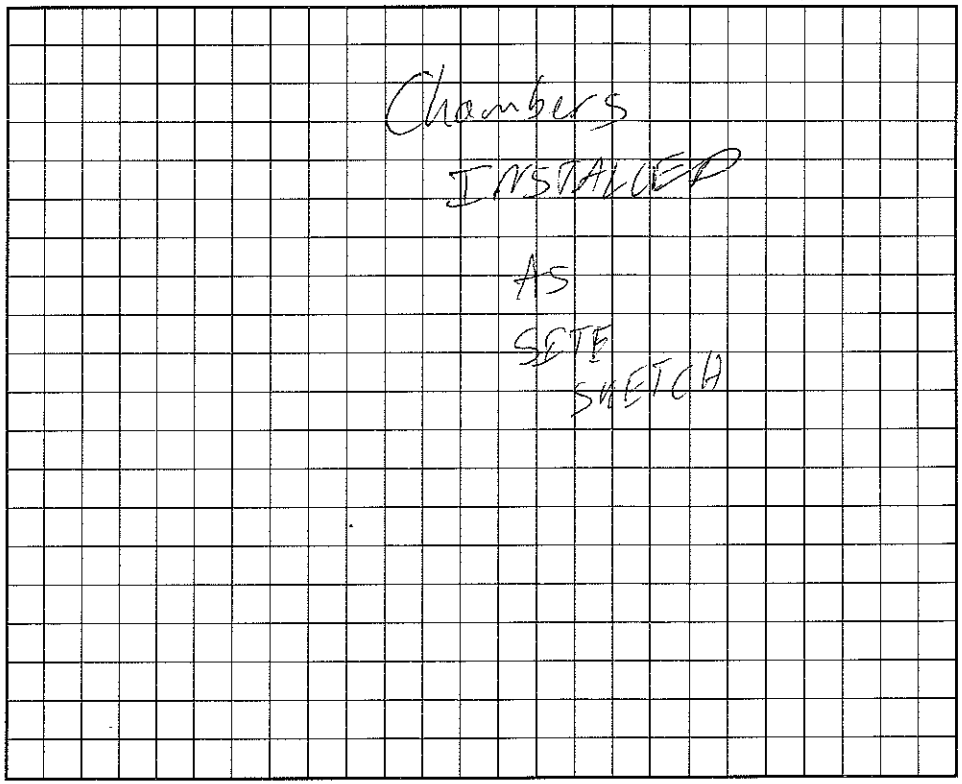

I understand that this permit can be suspended or revoked if any false information is supplied toward securing the permit/any unauthorized changes are made to the site/any unauthorized changes are made in the installation of the system.

Signed: Carl A. Brown

Improvement Permit by: C. Fahnestock date 10/23/96

Existing System Inspection by: C. Fahnestock date 10/23/96

Installed by: LARRY BEAM

Certificate of Completion by: date

Operation Permit by: C. Fahnestock EHSP date 10/25/96

HEALTH DEPT. COPY: WHITE INSPECTION COPY (FINAL): GREEN OWNER COPY (FINAL): YELLOW INSPECTION COPY (INITIAL): PINK OWNER COPY (INITIAL): GOLD