IREDELL COUNTY HEALTH DEPARTMENT

Repair

STATESVILLE 704-878-5305 MOORESVILLE 704-664-5281

IMPROVEMENT PERMIT / AUTHORIZATION TO CONSTRUCT / OPERATION PERMIT / EXISTING SYSTEM INSPECTION

PERMIT# N/A PIN# 4668943852.000 DATE 4/3/08

OWNER OR APPLICANT Helen O. Misenheimer PHONE: Business _____ Home 704 663-7194

ADDRESS 1109 Mt. Ulla Hwy (801)

LOCATION Hwy 150 W TR Hwy 801 N on Left ≈ 1-2 miles 1109 Mt. Ulla Hwy

SUBDIVISION N/A BLOCK / SECTION _____ LOT _____ LOT AREA ≈ 9 ac SITE CLASS. _____ DESIGN FLOW _____ L.T.A.R. _____

Septic Tank: 1000 new Gallons: STB _____ Date _____
Pump Tank: _____ Gallons: PT _____ Date _____
Pump Make: _____ Model _____ Serial No. _____
Nitrification Field: No Fields ~~Square Feet~~ ~~Linear Feet~~ Exis
No Lines _____ Trench Width _____ Max Trench Bottom Depth _____

☐ New System ☑ Repair ☐ Expansion System Type: I II III IV V VI
System Description: _____
Repair System Description: Repair
Maintenance Agreement Required: ☐ Yes ☐ No

☑ House/Mod. Home No. Bedrooms 2
☐ Mobile Home No. Persons _____
☐ Business No. Employees _____
☐ Other _____


Water Supply: ☑ Individual ☐ Public ☐ Community

Gravel Depth N/A ☑ Gravity ☐ Pressure ☐ Slab ☑ ~~Crawl~~ Space ☑ Basement w/plumbing ☐ Basement wo/plumbing

Comments:/Conditions:

Comments:/Conditions: Existing Septic tank top has caved in. Have concrete top replaced, system pumped out and install new PVC ~~Tank~~ w/approved filter

INITIAL SITE SKETCH

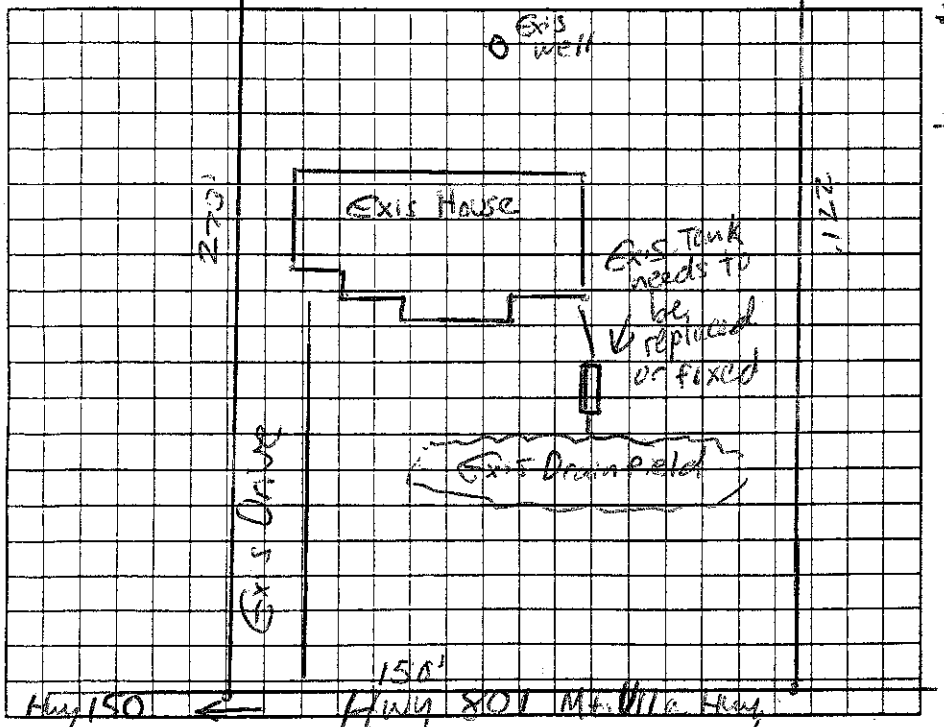

AS BUILT SKETCH

* Or Install new 1000 gallon Septic Tank w/ approved filter.
* Call Health department to inspect installation before covering Septic tank.

Permit can be suspended or revoked if any false information is supplied toward securing the permit/any unauthorized changes are made to the site/any unauthorized changes are made in the installation of the system. Improvement Permit with plat valid without expiration ☐ Improvement Permit with site plan valid for sixty months ☐ Authorization to Construct is valid for a period equal to that of Improvement Permit – not to exceed sixty months.

Signed: Helen O Misenheimer date 4/4/08
Improvement Permit by: Anthony Cober Jr. date 4/4/08
Authorization to Construct by: Anthony Cober Jr. date 4/4/08

Installed by: Mossy Septic Tank
Operation Permit by: Wesley Sperry date 4/18/08
Existing System Inspection by: _____ date _____

HEALTH DEPT. COPY: WHITE OWNER COPY (FINAL): YELLOW OWNER COPY (INITIAL): PINK