IREDELL COUNTY HEALTH DEPARTMENT

STATESVILLE 704-878-5305 50.00 Paid MOORESVILLE 704-664-5281

IMPROVEMENT PERMIT / AUTHORIZATION TO CONSTRUCT / OPERATION PERMIT / EXISTING SYSTEM INSPECTION

PERMIT# 089102 PIN# ~~4766900365~~ Pt 4669-60-0221 DATE 8-8-02

OWNER OR CONTRACTOR RW Rorie Construction (former KES) PHONE: Business 662-9170 Home

ADDRESS 105 Denver Business Pk Mooresville NC 28117

LOCATION Hwy 115/21 N TR Shinnville TL Brookglen TL Rocky Pt #135 On left

SUBDIVISION Brookglen BLOCK / SECTION 1 LOT 37 LOT AREA 1.06Acre SITE CLASS. PS DESIGN FLOW 360gpd L.T.A.R. 1.3

Septic Tank: 1000 Gallons; STB 1012 Date 5-4-02

Pump Tank: 1000 Gallons; PT 17 Date 6-23-02

Pump Make: Model Serial No.

Nitrification Field: No Fields 1 Square Feet 780' Linear Feet 260'

No Lines 3086' Trench Width 36" Max Trench Bottom Depth 36" Gravel Depth N/A

X New System ☐ Repair System Type: I, II, III, IV, V, VI

System Description Gravity - 35% Reduction

Repair System Description Pump - 25% Reduction

Maintenance Agreement Required: ☐ Yes X No

☐ Slab X Crawl Space ☐ Basement w/plumbing ☐ Basement wo/plumbing

X House/Mod. Home No. Bedrooms 3

☐ Mobile Home No. Bathrooms 2.5

☐ Business No. Employees


☐ Other

Water Supply: X Individual ☐ Public ☐ Community


Comments/Conditions: Well not installed at time of inspection.

Comments/Conditions: * 35% Reduction of Drainfield Area (warranty attached) *Final grading not complete-need NEMA 4X box Checked tanks, lines & pressure - MD If above grade

INITIAL SITE SKETCH Scale 1:50

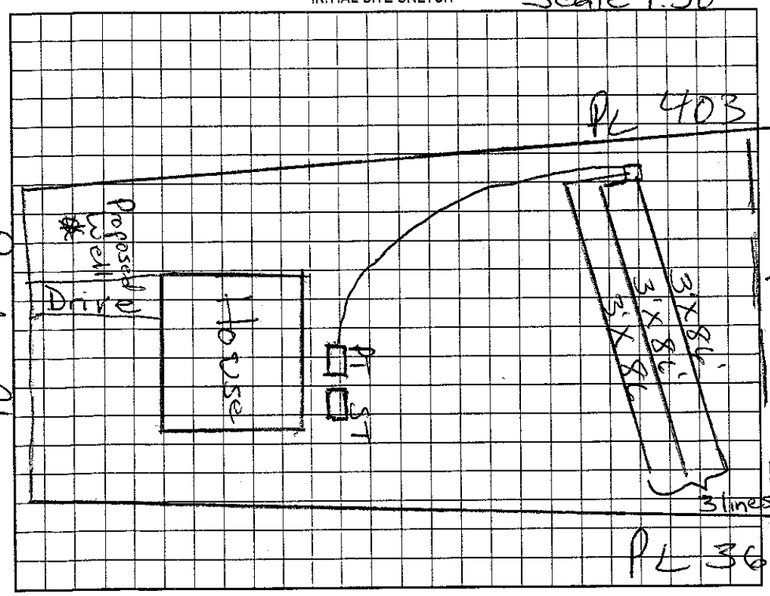

AS BUILT SKETCH

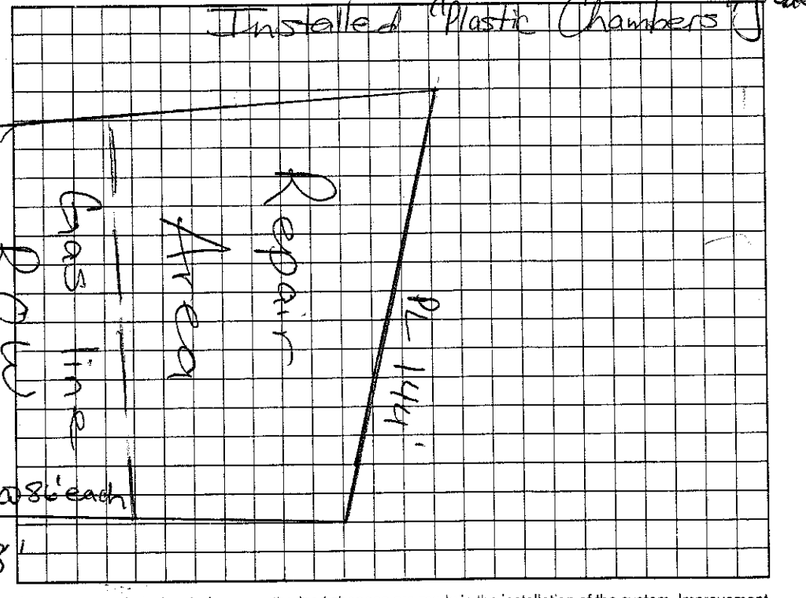

Permit can be suspended or revoked if any false information is supplied toward securing the permit/any unauthorized changes are made to the site/any unauthorized changes are made in the installation of the system. Improvement Permit with plan valid without expiration. Improvement Permit with site plan valid for sixty months. Authorization to Construct is valid for a period equal to that of Improvement Permit – not to exceed sixty months.

Signed: X Russell W Rorie date

Improvement Permit by: Maintha H Dolson R.S. date 8-8-02

Authorization to Construct by: Maintha H Dolson RS date 8-8-02

Installed by: Tommy Frye

Operation Permit by: Maintha H Dolson R.S. date 9/4/2002

Existing System Inspection by: date

HEALTH DEPT. COPY: WHITE OWNER COPY (FINAL): YELLOW OWNER COPY (INITIAL): PINK