4100

IREDELL COUNTY HEALTH DEPARTMENT

STATESVILLE 704-878-5305 MOORESVILLE 704-664-5281

IMPROVEMENT PERMIT / AUTHORIZATION TO CONSTRUCT / OPERATION PERMIT / EXISTING SYSTEM INSPECTION

PERMIT# 089103 PIN# 4669 00 3656 PT 4669000443 DATE 10/31/01

OWNER OR CONTRACTOR KFS INVESTMENTS (RW Rowe Const.) PHONE: Business 664-3671 Home

ADDRESS 149 YACHT COVE LN MOORESVILLE - NC 28115

LOCATION 115N - TR SHANNVILLE - TL BROOKGLEN - TL ROCKY POINT - ON LT

SUBDIVISION BROOKGLEN BLOCK / SECTION 1 LOT 38 LOT AREA .824C SITE CLASS. PS DESIGN FLOW 360 GPD L.T.A.R. .3 GPD/SF

Septic Tank: 1000 Gallons; STB 1012 Date 3-11-02
Pump Tank: 1000 Gallons; PT 17 Date 6-24-02
Pump Make: Goulds Model WE05511H Serial No. 5-24-02
Nitrification Field: No Fields 1 Square Feet 900 Linear Feet 300
No Lines 3@100 Trench Width 36" Max Trench Bottom Depth 36" Gravel Depth N/A

☑ New System ☐ Repair System Type: I, II, III, IV, V, VI
System Description: PUMP 25% REDUCTION
Repair System Description: PUMP PANEL
Maintenance Agreement Required: ☐ Yes ☑ No
☐ Slab ☐ Crawl Space ☒ Basement w/plumbing ☐ Basement wo/plumbing


☑ House/Mod. Home No. Bedrooms 3
☐ Mobile Home No. Bathrooms 3
☐ Business No. Employees
☐ Other

Water Supply: ☑ Individual ☐ Public ☐ Community


Comments/Conditions: To be located distances shown on IP. Well not installed at time of inspection

Comments/Conditions: 8/1/02 Checked tanks, lines & pressure 8/9/02 Final grading not done yet, must keep New 4 x box 1' Feet above grade

INITIAL SITE SKETCH 1"=50'

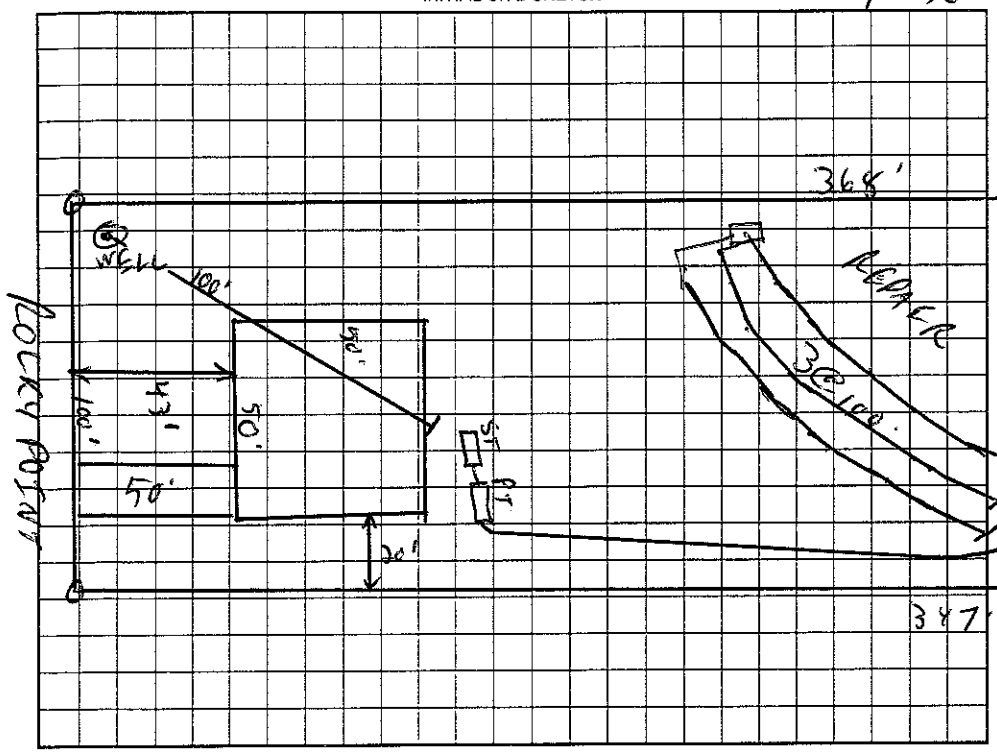

AS BUILT SKETCH

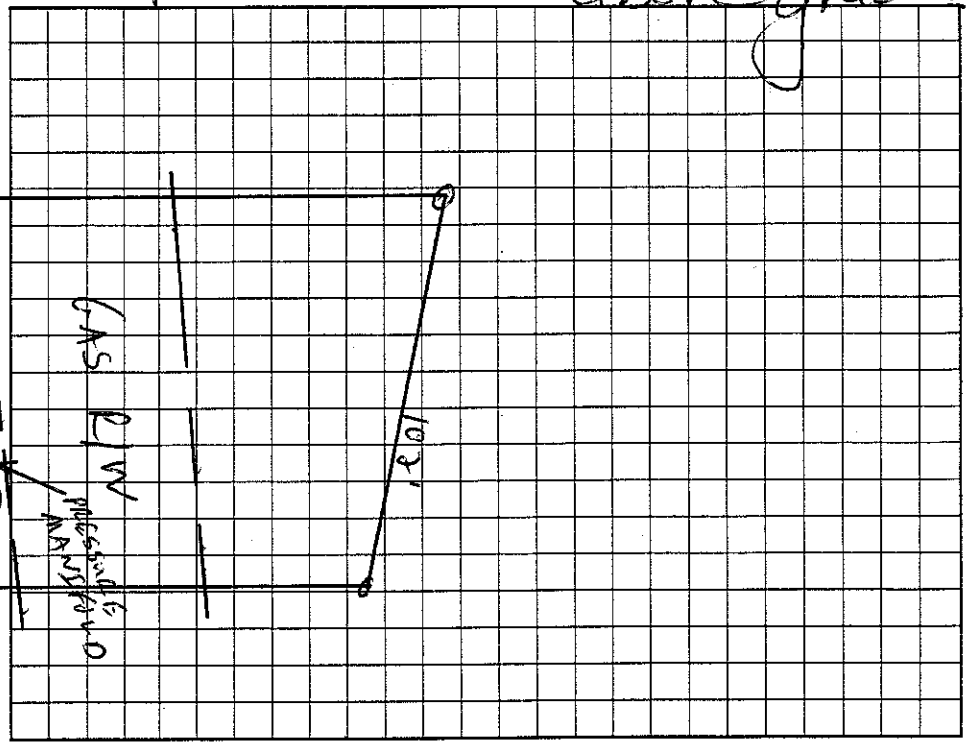

Permit can be suspended or revoked if any false information is supplied toward securing the permit/any unauthorized changes are made to the site/any unauthorized changes are made in the installation of the system. Improvement Permit with plat valid without expiration. Improvement Permit with site plan valid for sixty months. Authorization to Construct is valid for a period equal to that of Improvement Permit – not to exceed sixty months.

Signed: ~~~~ date 11.6.01 Installed by: Tommy Frye

Improvement Permit by: C. [illegible] RS date 10/31/01 Operation Permit by: [illegible] R.S. date 9/6/2002

Authorization to Construct by: Wesley Sparks R.S. date 4/16/02 Existing System Inspection by: date

HEALTH DEPT. COPY: WHITE OWNER COPY (FINAL): YELLOW OWNER COPY (INITIAL): PINK